



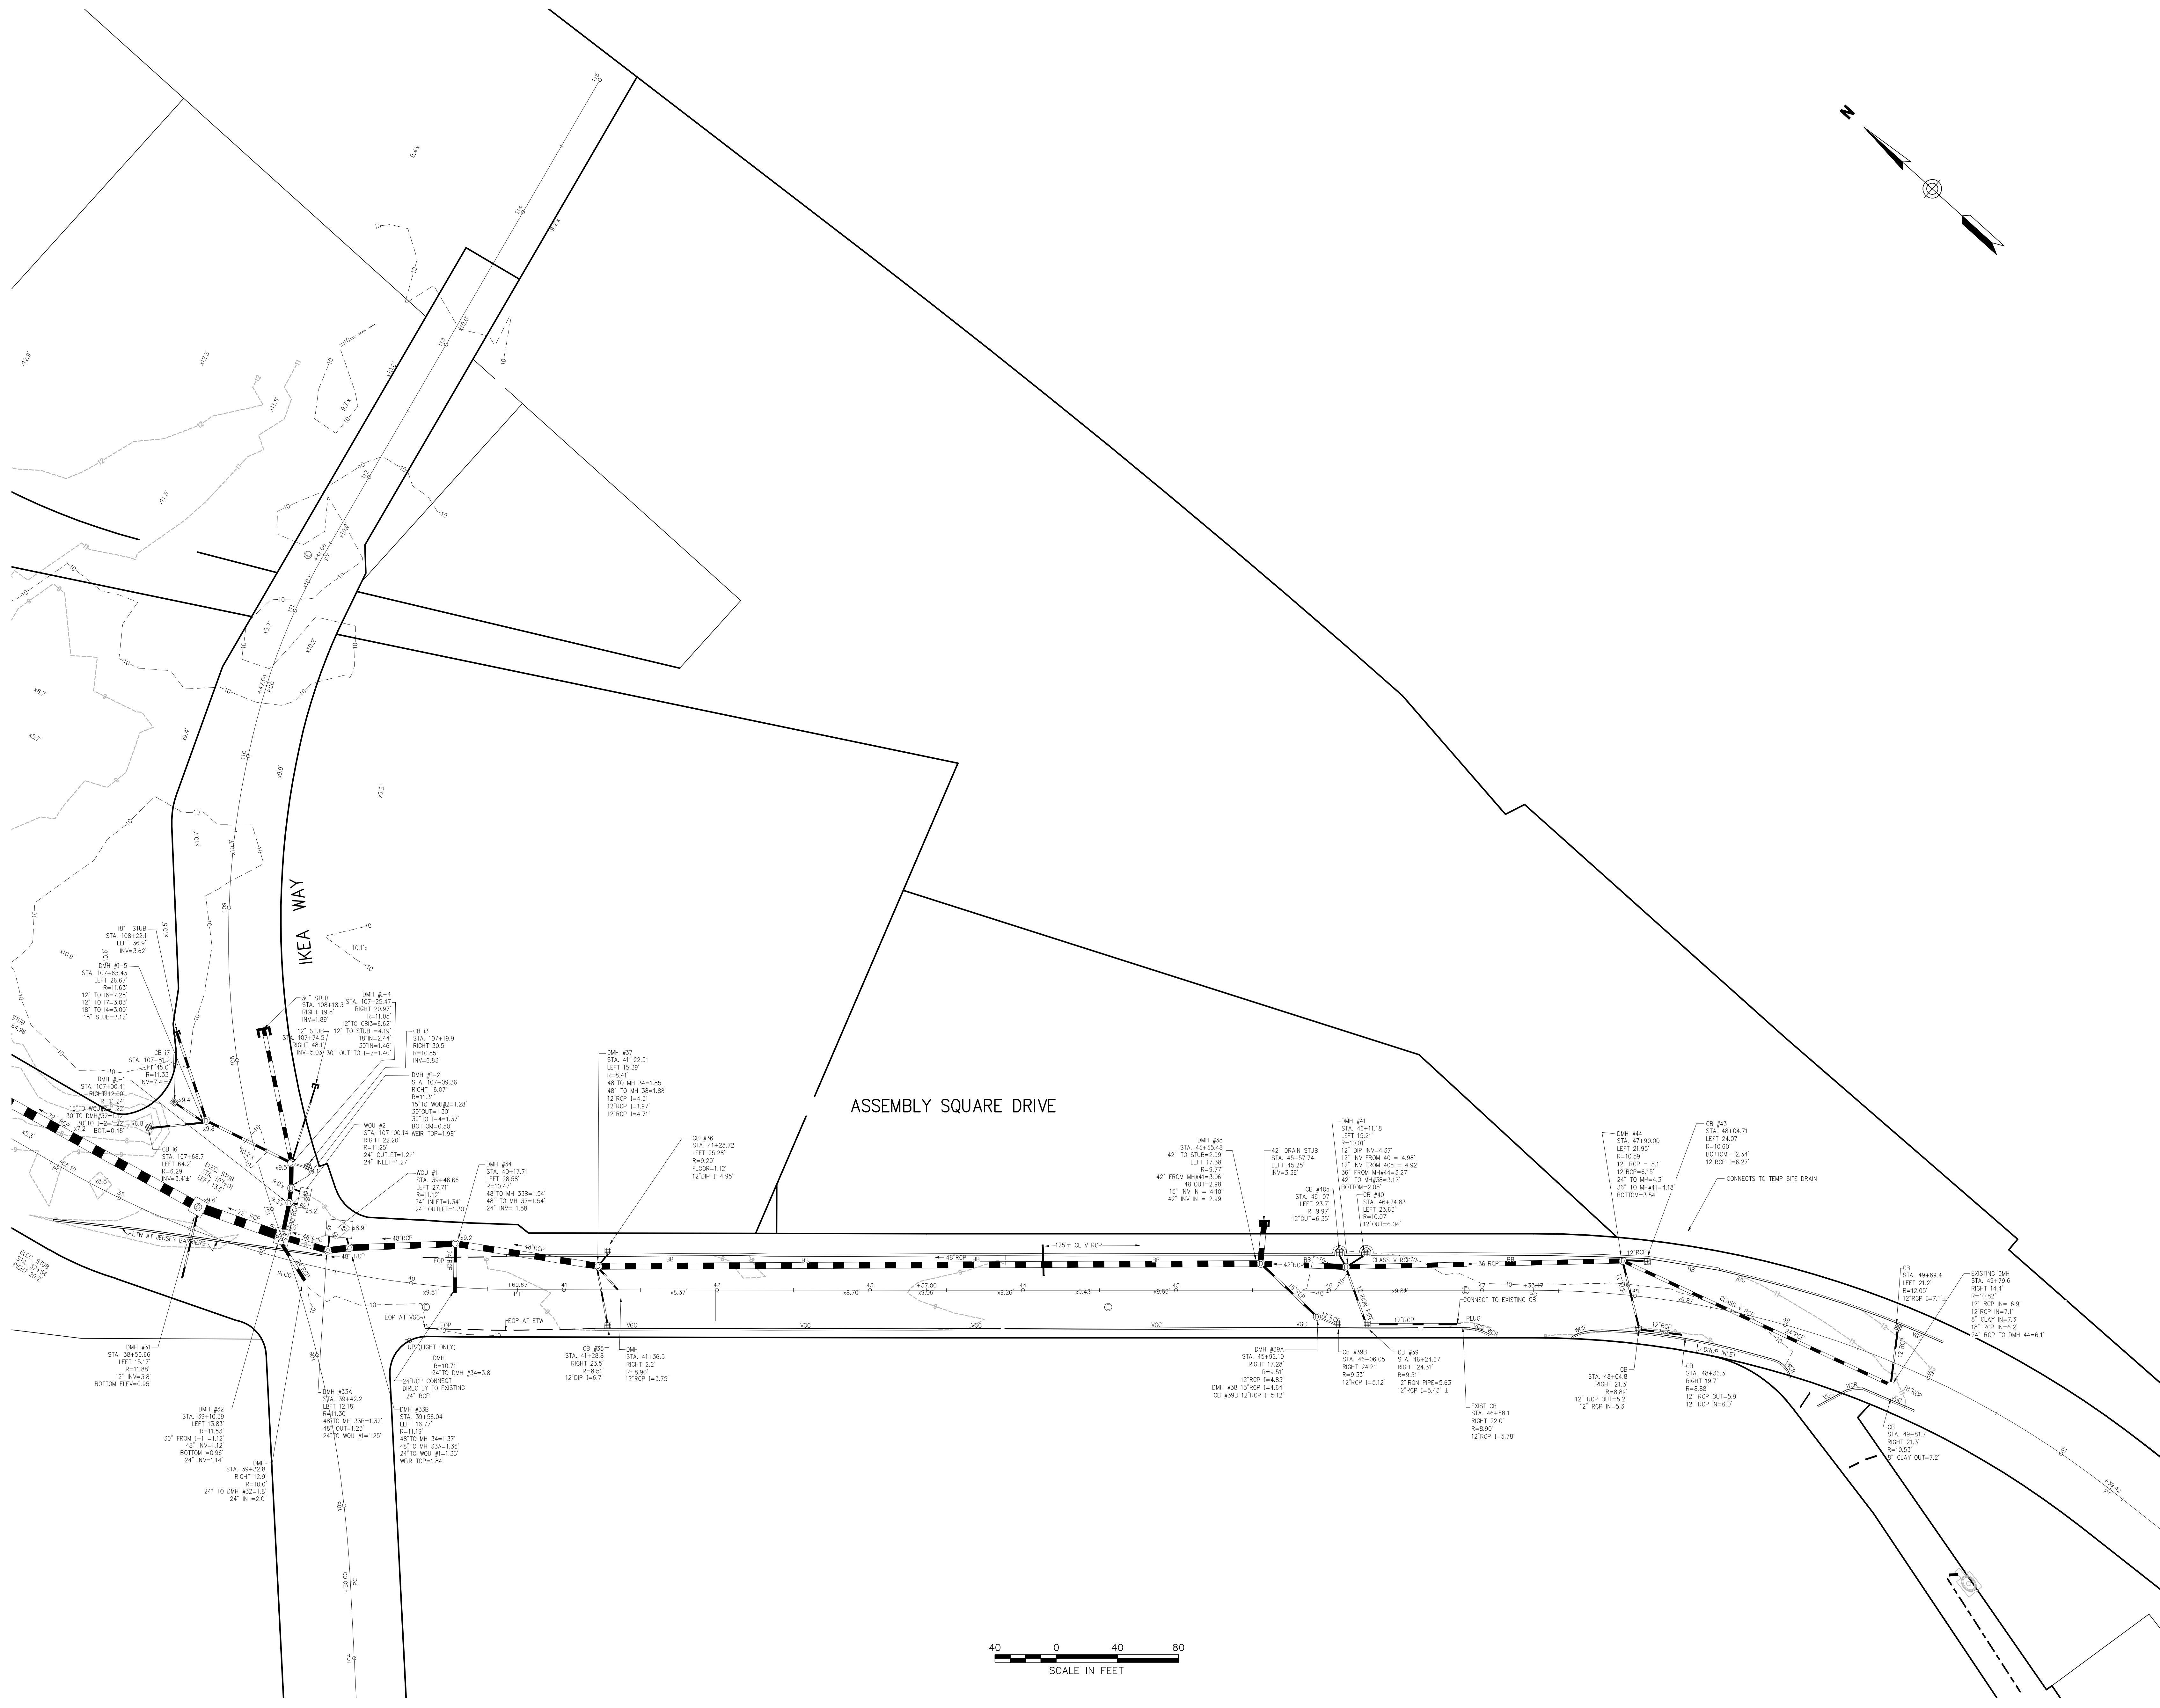

Vanasse Hangen Brustlin, Inc.

Transportation
Land Development
Environmental Services

101 Walnut Street, P.O. Box 9151
Watertown, Massachusetts 02471-9151
617 924 1770 • FAX 617 924 2286

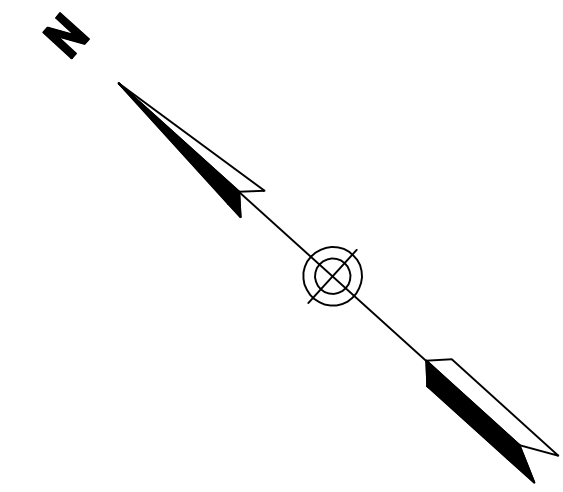

Legend

- X,XX' ELEVATION NOT OBTAINABLE
- ⊙ DMH
- ▣ CB
- ⊙ SMH
- ⊙ EMH
- ⊙ TMH
- MANHOLE
- ⊙ HANDHOLE
- ⊙ WATER GATE
- ⊙ FIRE HYDRANT
- ⊙ GAS GATE
- ☆ LIGHT POLE
- ⊙ UTILITY POLE
- ⊙ GUY WIRE
- ⊙ GUY POLE
- ⊙ MONITORING WELL
- EOP
- CC
- EDGE OF PAVEMENT
- CONCRETE CURB
- VERTICAL GRANITE CURB
- SLOPED GRANITE EDGE
- BITUMINOUS BERM
- GUARD RAIL
- CHAIN LINK FENCE
- DRAINAGE LINE
- SEWER LINE
- OVERHEAD WIRE
- UNDERGROUND ELECTRIC
- TELEPHONE LINE
- GAS LINE
- WATER LINE
- R.O.W. LINES

ASSEMBLY SQUARE DRIVE

IKEA WAY



edited plan based on peer review comments		3/4/10	bgp
No.	Revision	Date	Revised
Designed by	Drawn by	Checked by	
CAD checked by	Approved by		
Scale	1"=40'	Date	January 25, 2010

Assembly Square Drive

Somerville, Massachusetts
Issued for

Drawing Title
**Drain As-Built
Plan of Land**

Drawing Number
Sv-3

Sheet of
3 3
Project Number
10923.00