 




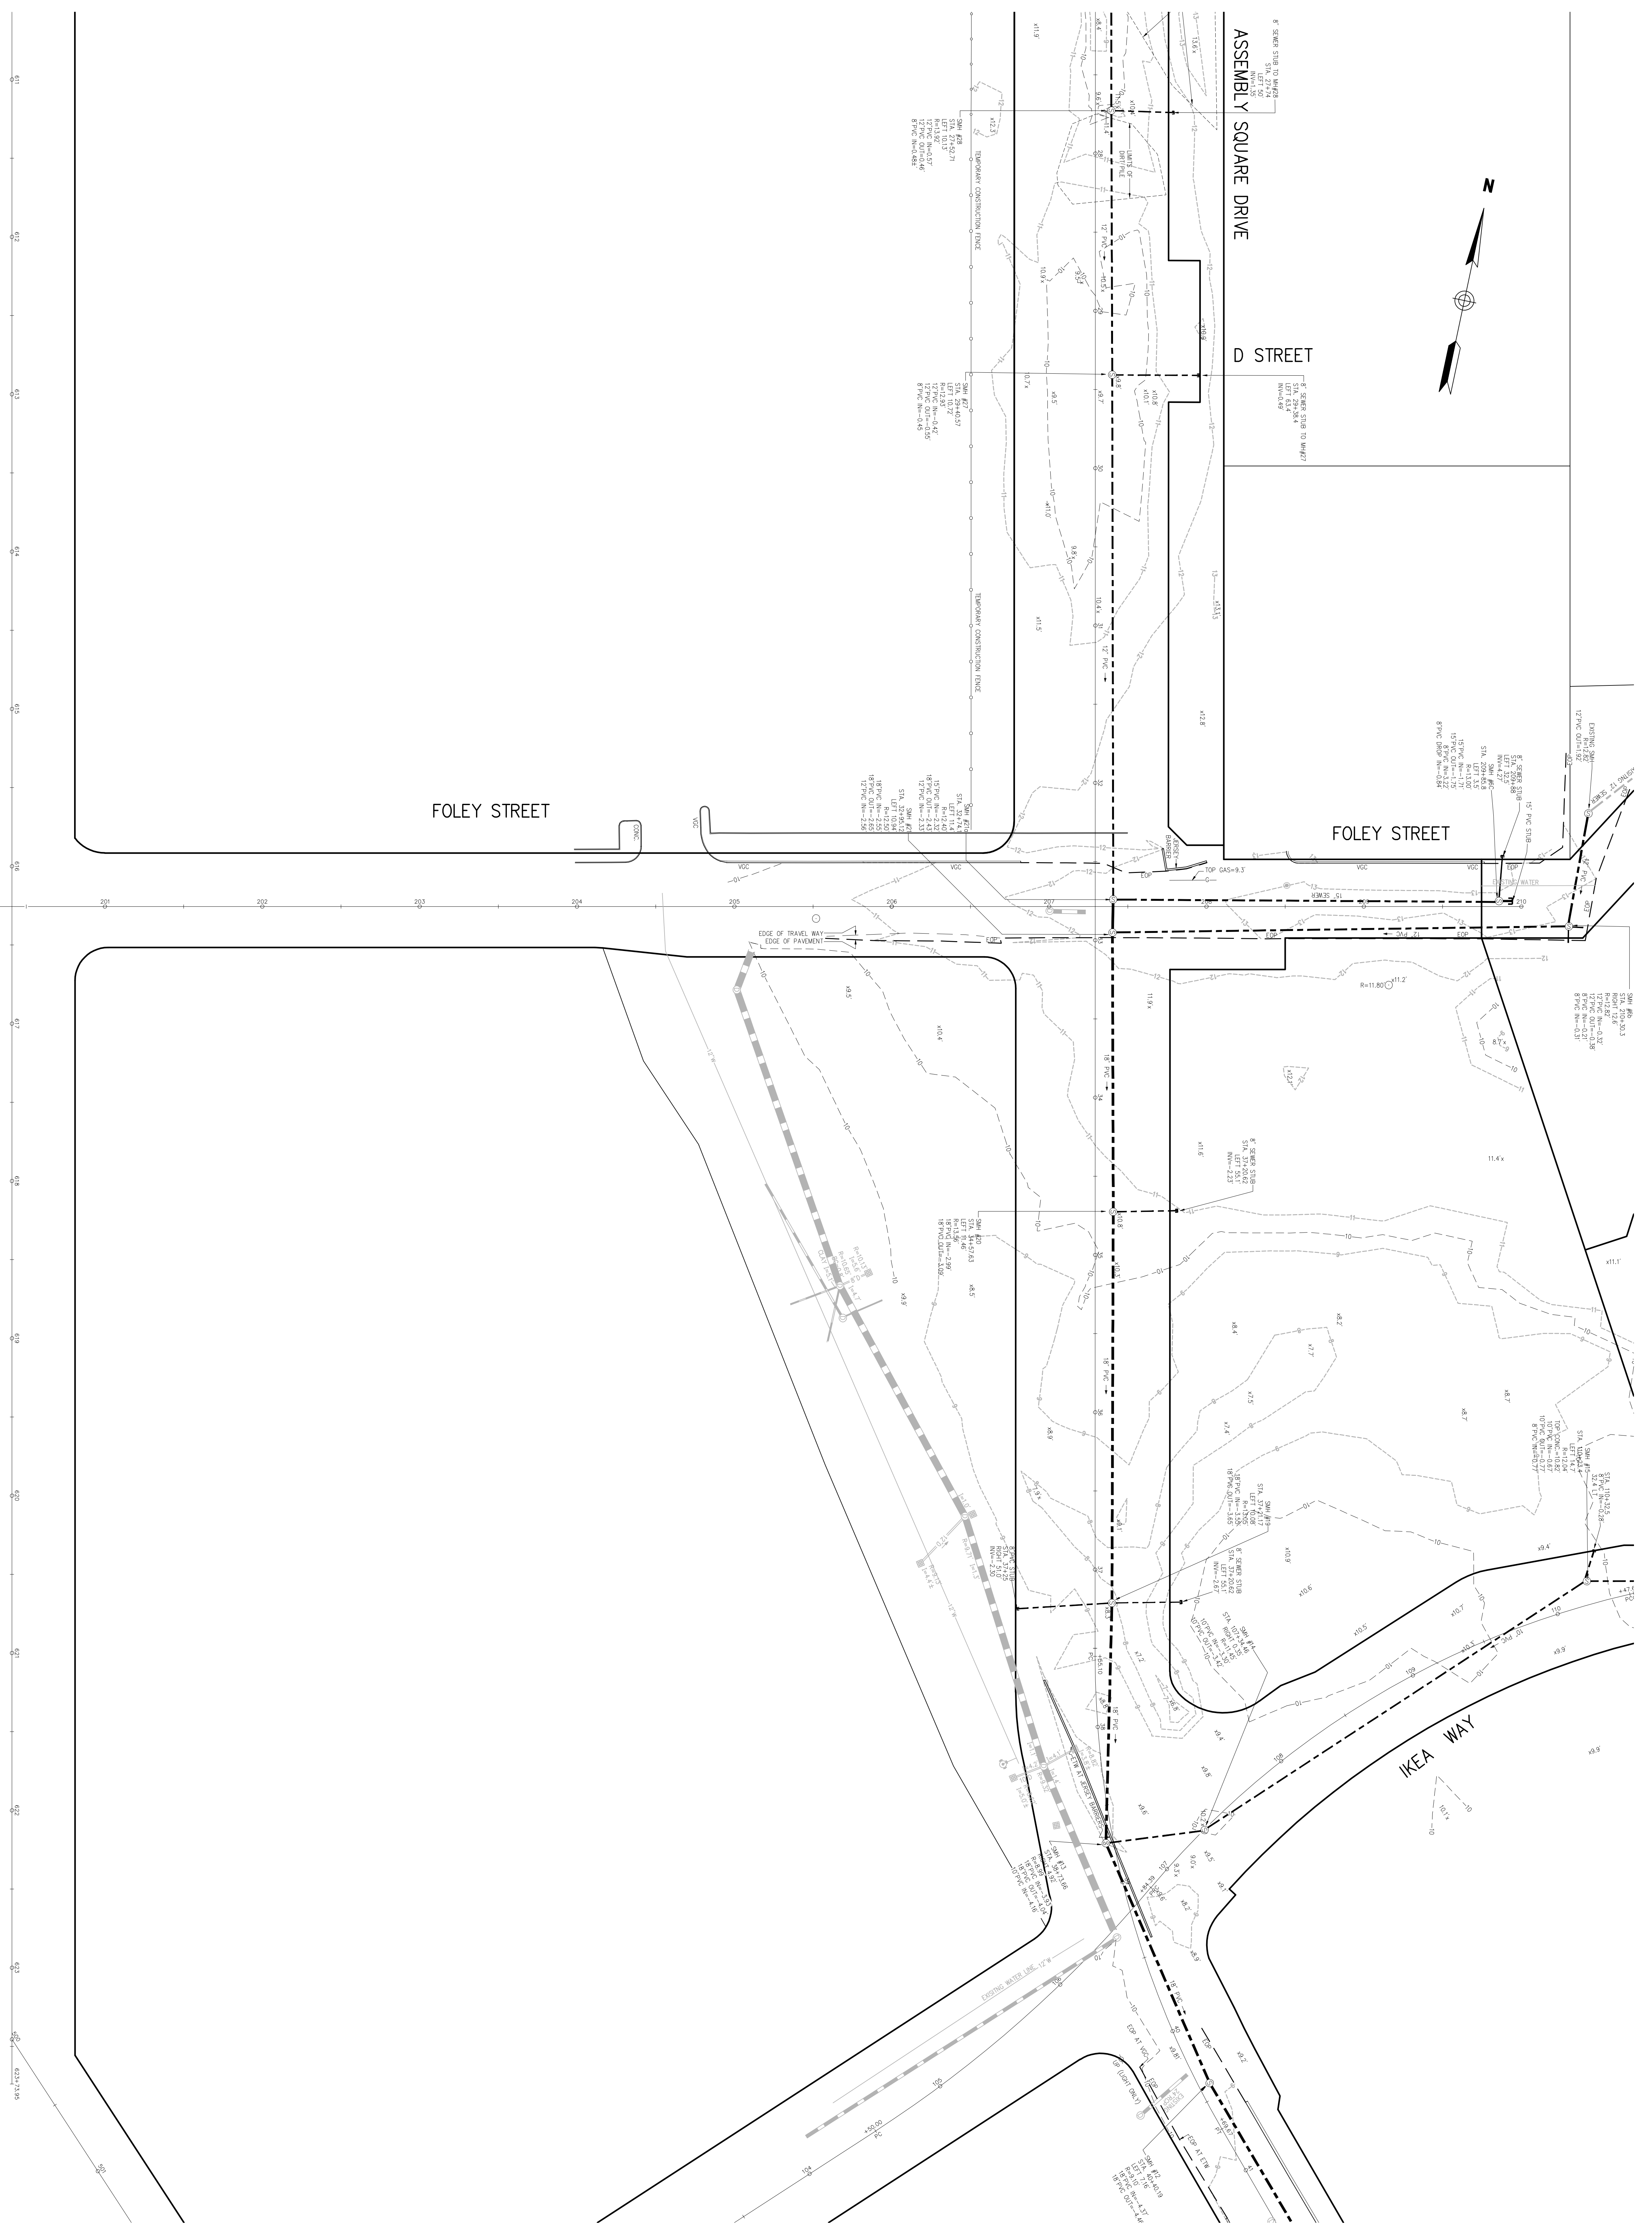

**Yanasse Hangen Brustlin, Inc.**  
 Transportation  
 Land Development  
 Environmental Services  
 101 Walnut Street, P.O. Box 9151  
 Watertown, Massachusetts 02471-9151  
 617.924.1770 • FAX 617.924.2286

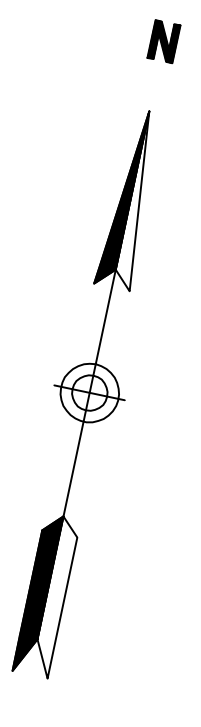

**Legend**

- X, Y ELEVATION NOT OBTAINABLE
- CB
- SMH
- CB
- SMH
- MANHOLE
- HANDHOLE
- WATER GATE
- GAS GATE
- LIGHT POLE
- UTILITY POLE
- GUY POLE
- MONITORING WELL
- EDGE OF PAVEMENT
- VERGED GRANITE CURB
- SLOPED GRANITE EDGE
- BIRMINGHAM BERM
- CHAIN LINK FENCE
- ORNAMENT LINE
- SEWER LINE
- OVERHEAD AND ELECTRIC
- TELEPHONE LINE
- GAS LINE
- WATER LINE
- R.O.M. LINES

NO.	DESCRIPTION	DATE	BY
1	Initial plan based on sewer	5/7/10	JHB
2	As-built	1/25/10	JHB
3	Final	1/25/10	JHB

2-D01 created by: JHB  
 1"=40'  
 Project Title: **Assembly Square Drive**  
 Date: **January 25, 2010**

**Somerville, Massachusetts**

**Sewer As-Built**  
**Plan of Land**

**SV-2**

Sheet 2 of 3  
 Project Number  
**10923.00**

\\Maservil\N\10923.00\Drawings\10923.00\_Sewer\_Alt.dwg