



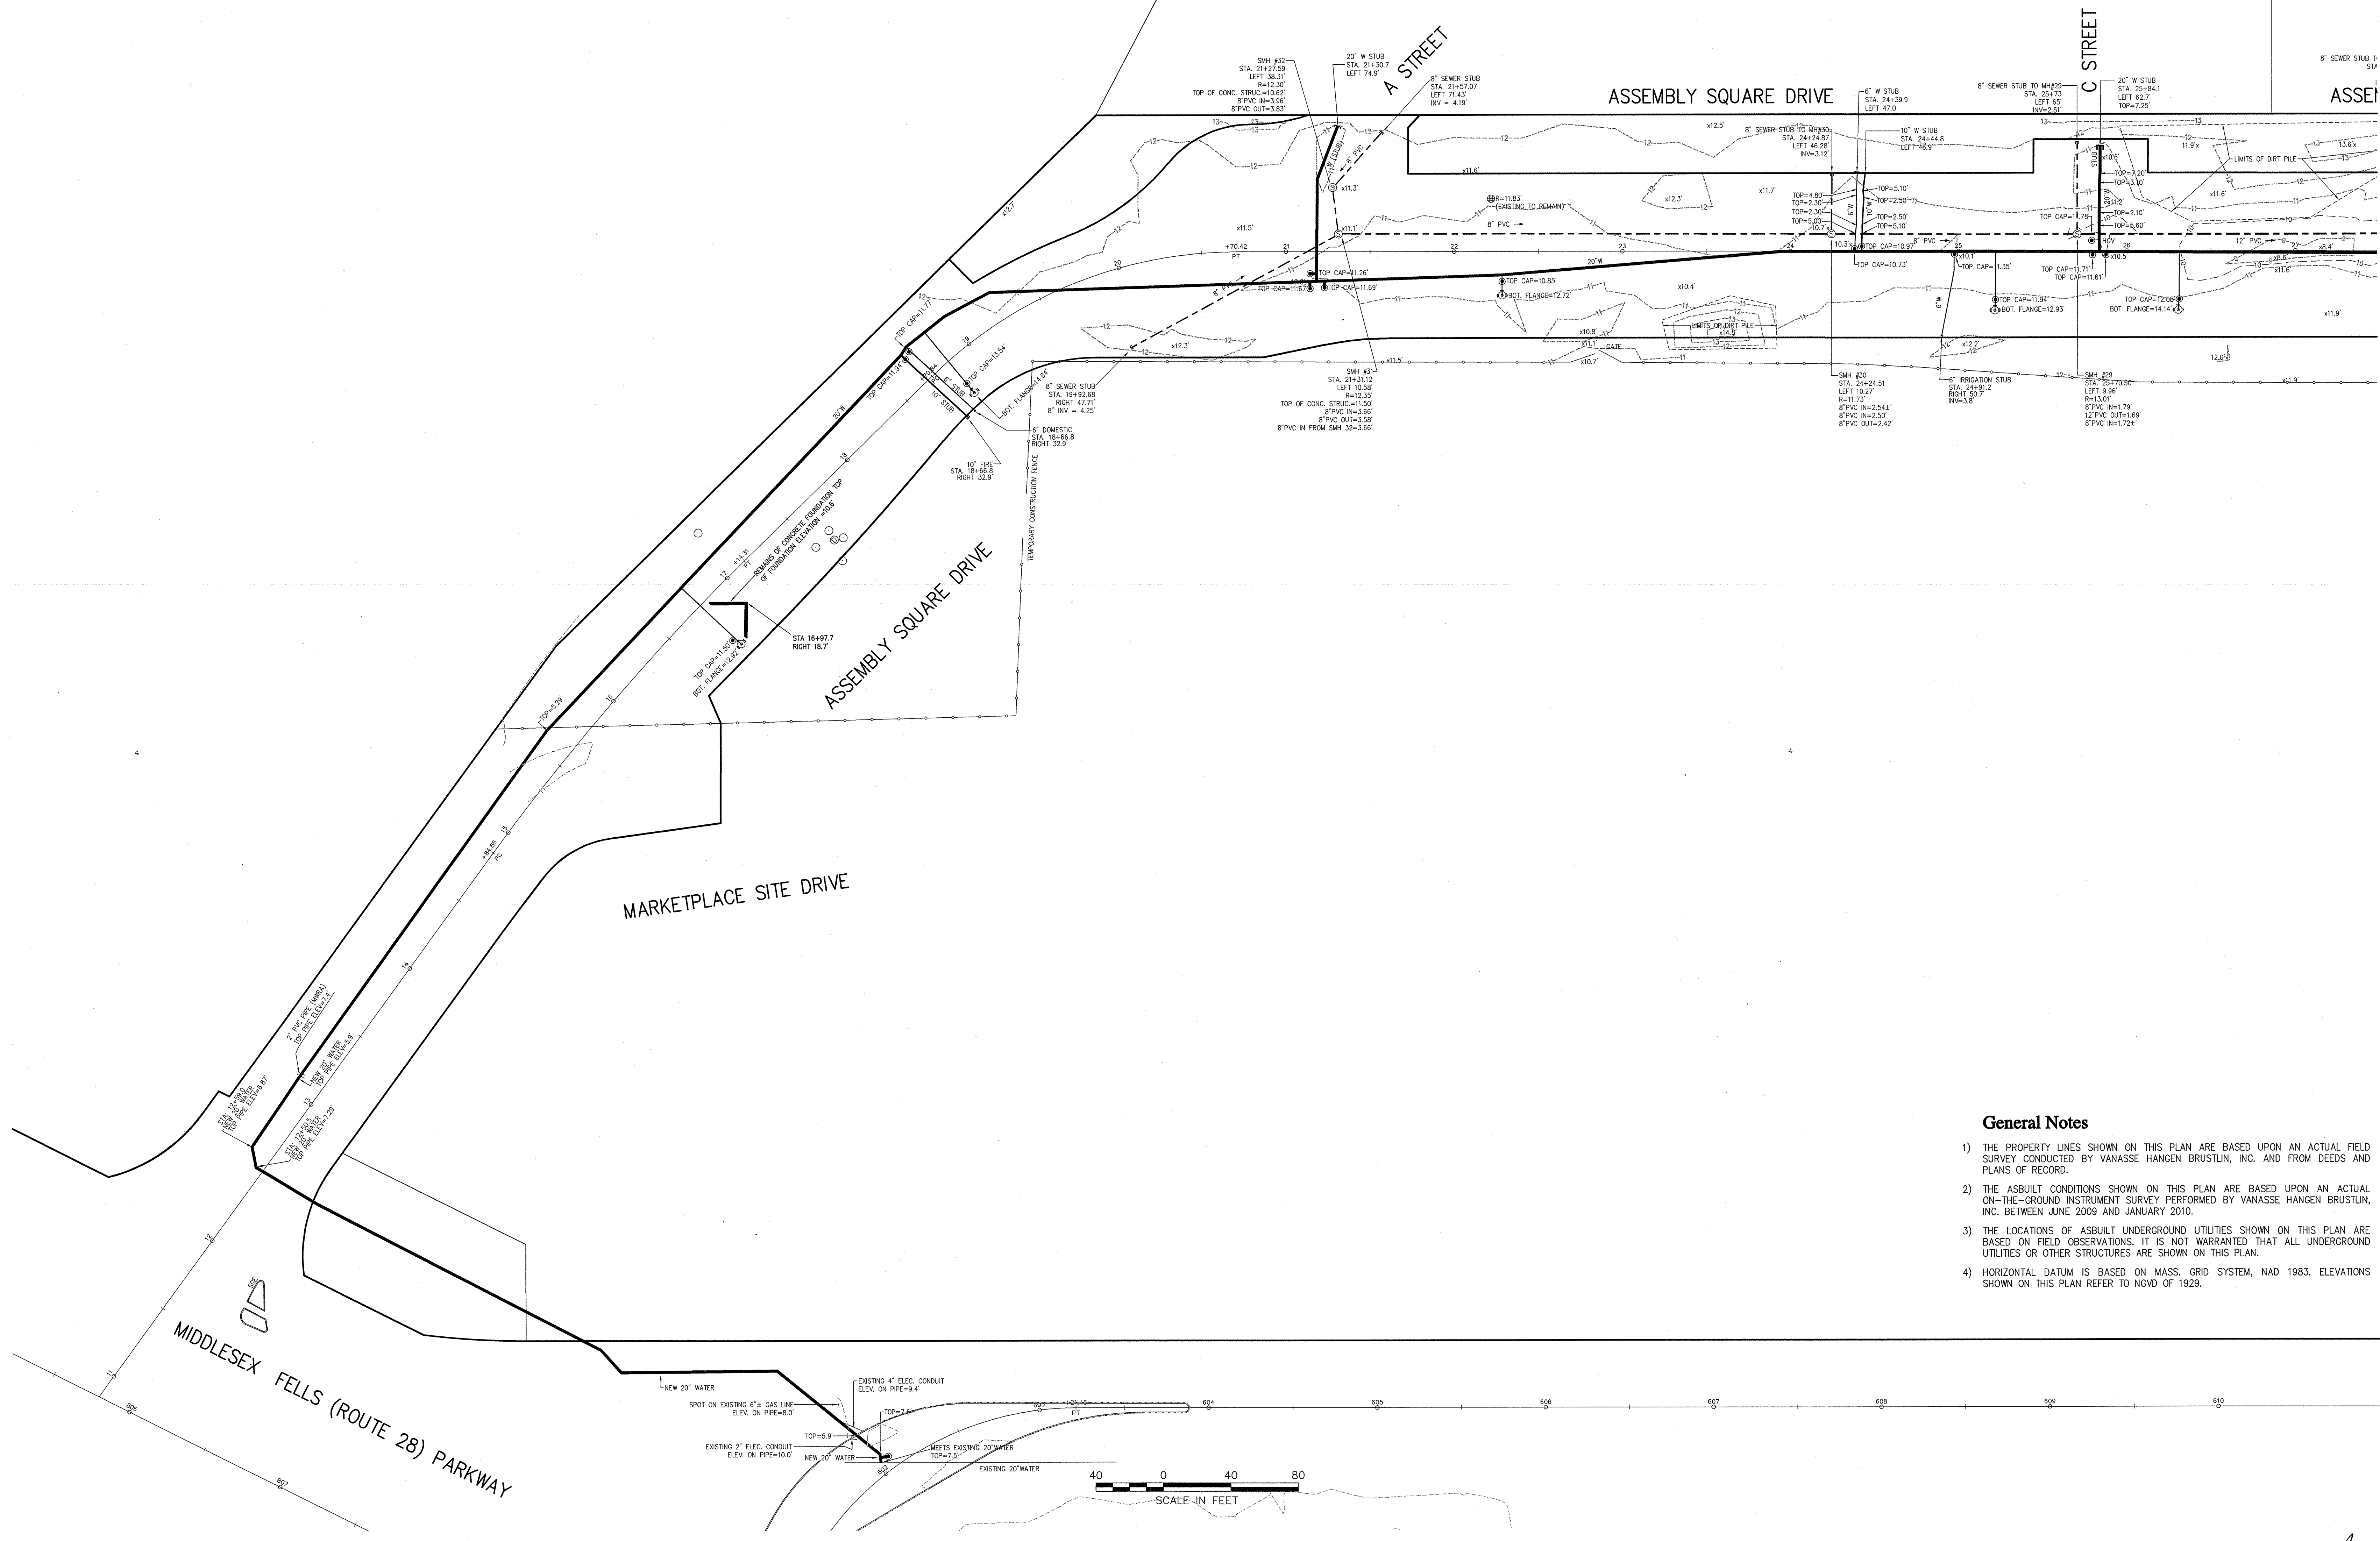

Vanasse Hangen Brustlin, Inc.

Transportation
Land Development
Environmental Services

101 Walnut Street, P.O. Box 9151
Watertown, Massachusetts 02471-9151
617 924 1770 • FAX 617 924 2286

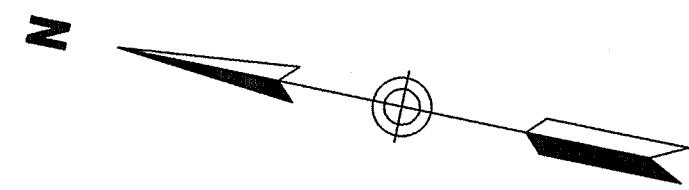

Legend

- XXX ELEVATION NOT OBTAINABLE
- DMH
- CB
- SMH
- EMH
- TMH
- MANHOLE
- HANDHOLE
- WATER GATE
- FIRE HYDRANT
- GAS GATE
- LIGHT POLE
- UTILITY POLE
- GUY WIRE
- GUY POLE
- MONITORING WELL
- EDGE OF PAVEMENT
- CONCRETE CURB
- VERTICAL GRANITE CURB
- SLOPED GRANITE EDGE
- BITUMINOUS BERM
- GUARD RAIL
- CHAIN LINK FENCE
- DRAINAGE LINE
- SEWER LINE
- OVERHEAD WIRE
- UNDERGROUND ELECTRIC
- TELEPHONE LINE
- GAS LINE
- WATER LINE
- R.O.W. LINES

1	edited plan based on peer review comments	3/4/10	top
No.	Revision	Date	Appr


Scale 1"=40' Date January 25, 2010

General Notes

- 1) THE PROPERTY LINES SHOWN ON THIS PLAN ARE BASED UPON AN ACTUAL FIELD SURVEY CONDUCTED BY VANASSE HANGEN BRUSTLIN, INC. AND FROM DEEDS AND PLANS OF RECORD.
- 2) THE ASBUILT CONDITIONS SHOWN ON THIS PLAN ARE BASED UPON AN ACTUAL ON-THE-GROUND INSTRUMENT SURVEY PERFORMED BY VANASSE HANGEN BRUSTLIN, INC. BETWEEN JUNE 2009 AND JANUARY 2010.
- 3) THE LOCATIONS OF ASBUILT UNDERGROUND UTILITIES SHOWN ON THIS PLAN ARE BASED ON FIELD OBSERVATIONS. IT IS NOT WARRANTED THAT ALL UNDERGROUND UTILITIES OR OTHER STRUCTURES ARE SHOWN ON THIS PLAN.
- 4) HORIZONTAL DATUM IS BASED ON MASS. GRID SYSTEM, NAD 1983. ELEVATIONS SHOWN ON THIS PLAN REFER TO NGVD OF 1929.

Somerville, Massachusetts
Issued for

Drawing Title
**Utility As-Built
Plan of Land**

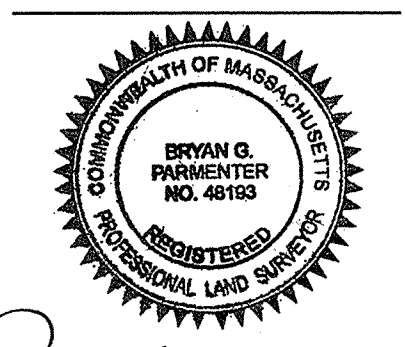

Drawing Number
Sv-1
Sheet of 1 3
Project Number
10923.00

By: *Bryan G. Wrentham* 3/15/2010
Path: \\jwald\id\10923.00\cad\sv\plonset\10923.00_Sewer_AB.dwg