



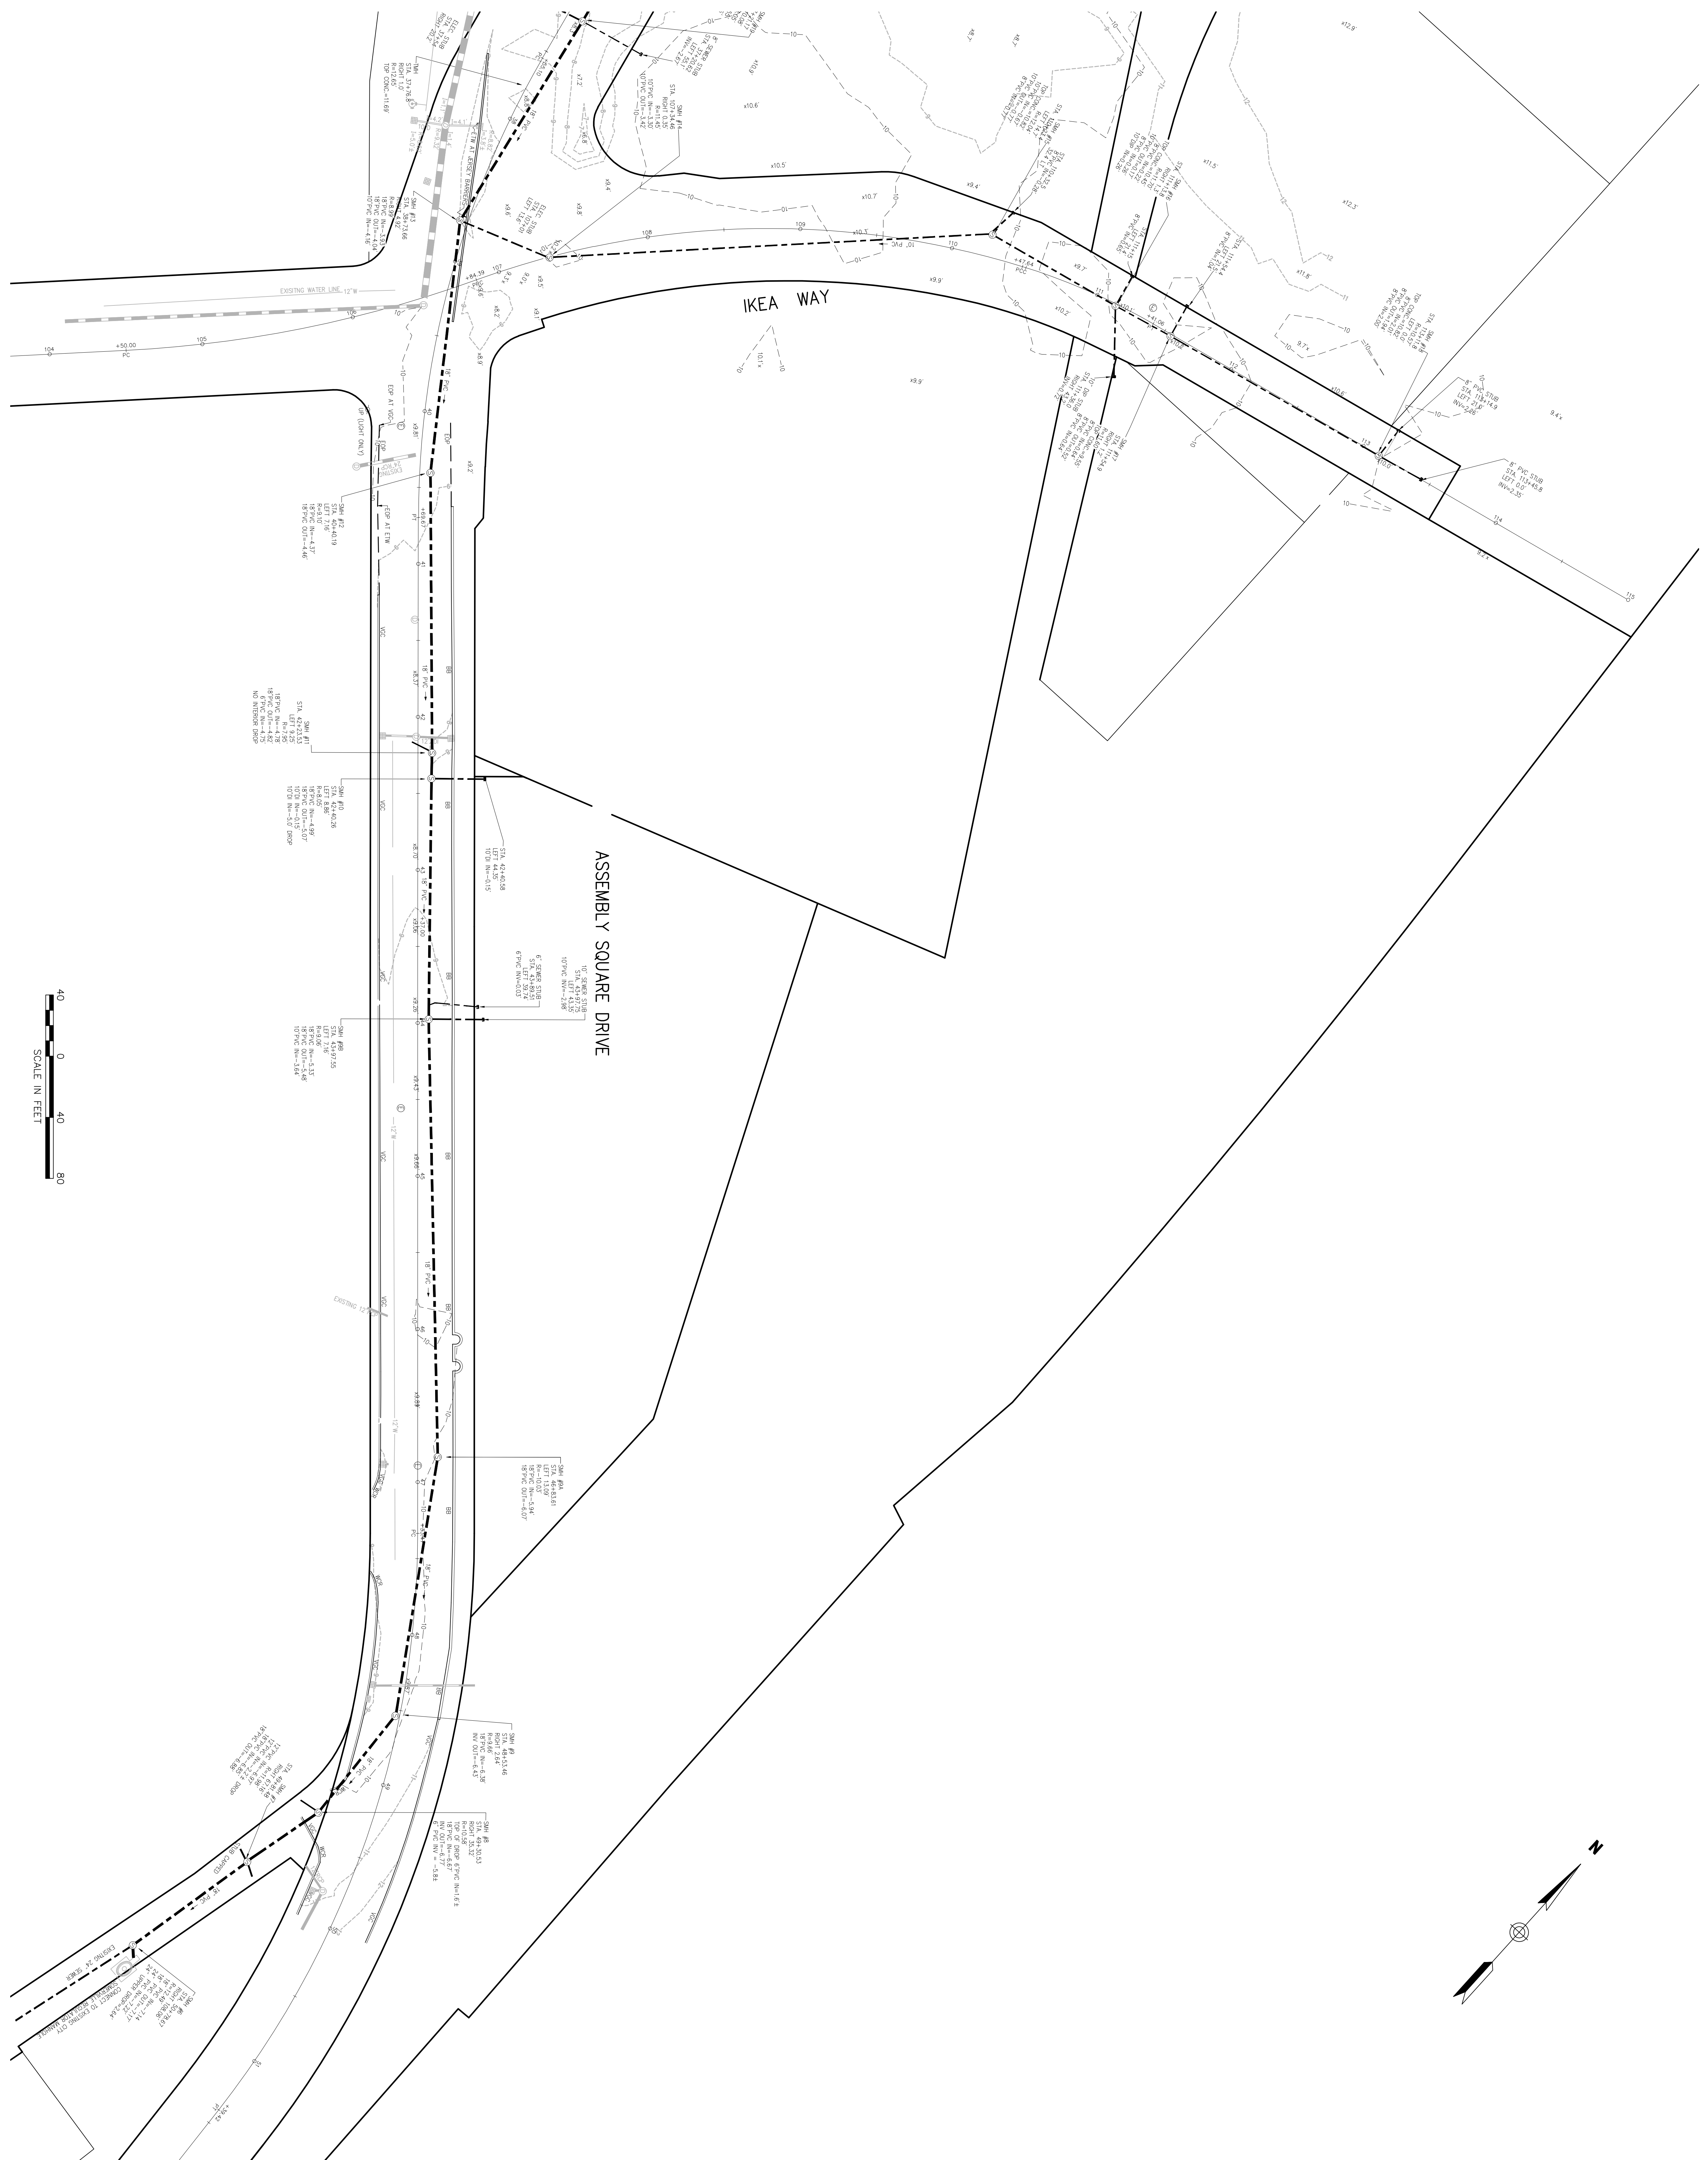

**Yanase Hangen Brushin, Inc.**  
Transportation  
Land Development  
Environmental Services  
101 Walnut Street, P.O. Box 9151  
Wareham, Massachusetts 02471-9151  
617.924.1770 • FAX 617.924.2286

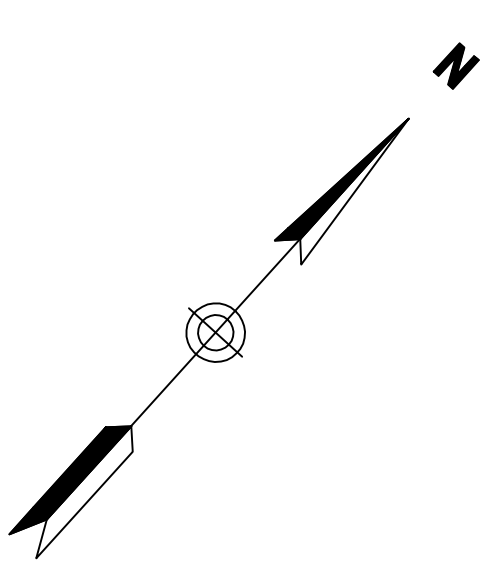

- Legend**  
X,XY ELEVATION NOT OBTAINABLE
- CB
  - SMH
  - EMH
  - MANHOLE
  - HANDHOLE
  - WATER GATE
  - WATER GATE
  - GAS GATE
  - LIGHT POLE
  - UTILITY POLE
  - UTILITY POLE
  - UTILITY POLE
  - MONITORING WELL
  - EDGE OF PAVEMENT
  - VERTICAL GRANITE CURB
  - SLOPED GRANITE EDGE
  - BIRMINGHAM BERM
  - ORANGE LINK FENCE
  - ORANGE LINK FENCE
  - SEWER LINE
  - SEWER LINE
  - OVERHEAD AND ELECTRIC
  - GAS LINE
  - WATER LINE
  - NO IN LINES

No.	Description	Scale	Revised	By
1	issued and bound as per	5/4/10		hsp
2	revision			
3	revision			

2-D30 created by: **hsp**  
Project Title: **Assembly Square Drive**  
Scale: **1"=40'**  
Date: **January 25, 2010**

**Assembly Square Drive**  
Somerville, Massachusetts

**Sewer As-Built**  
**Plan of Land**

**SV-3**

Scale: 3 of 3  
Project Number: 10923.00

