



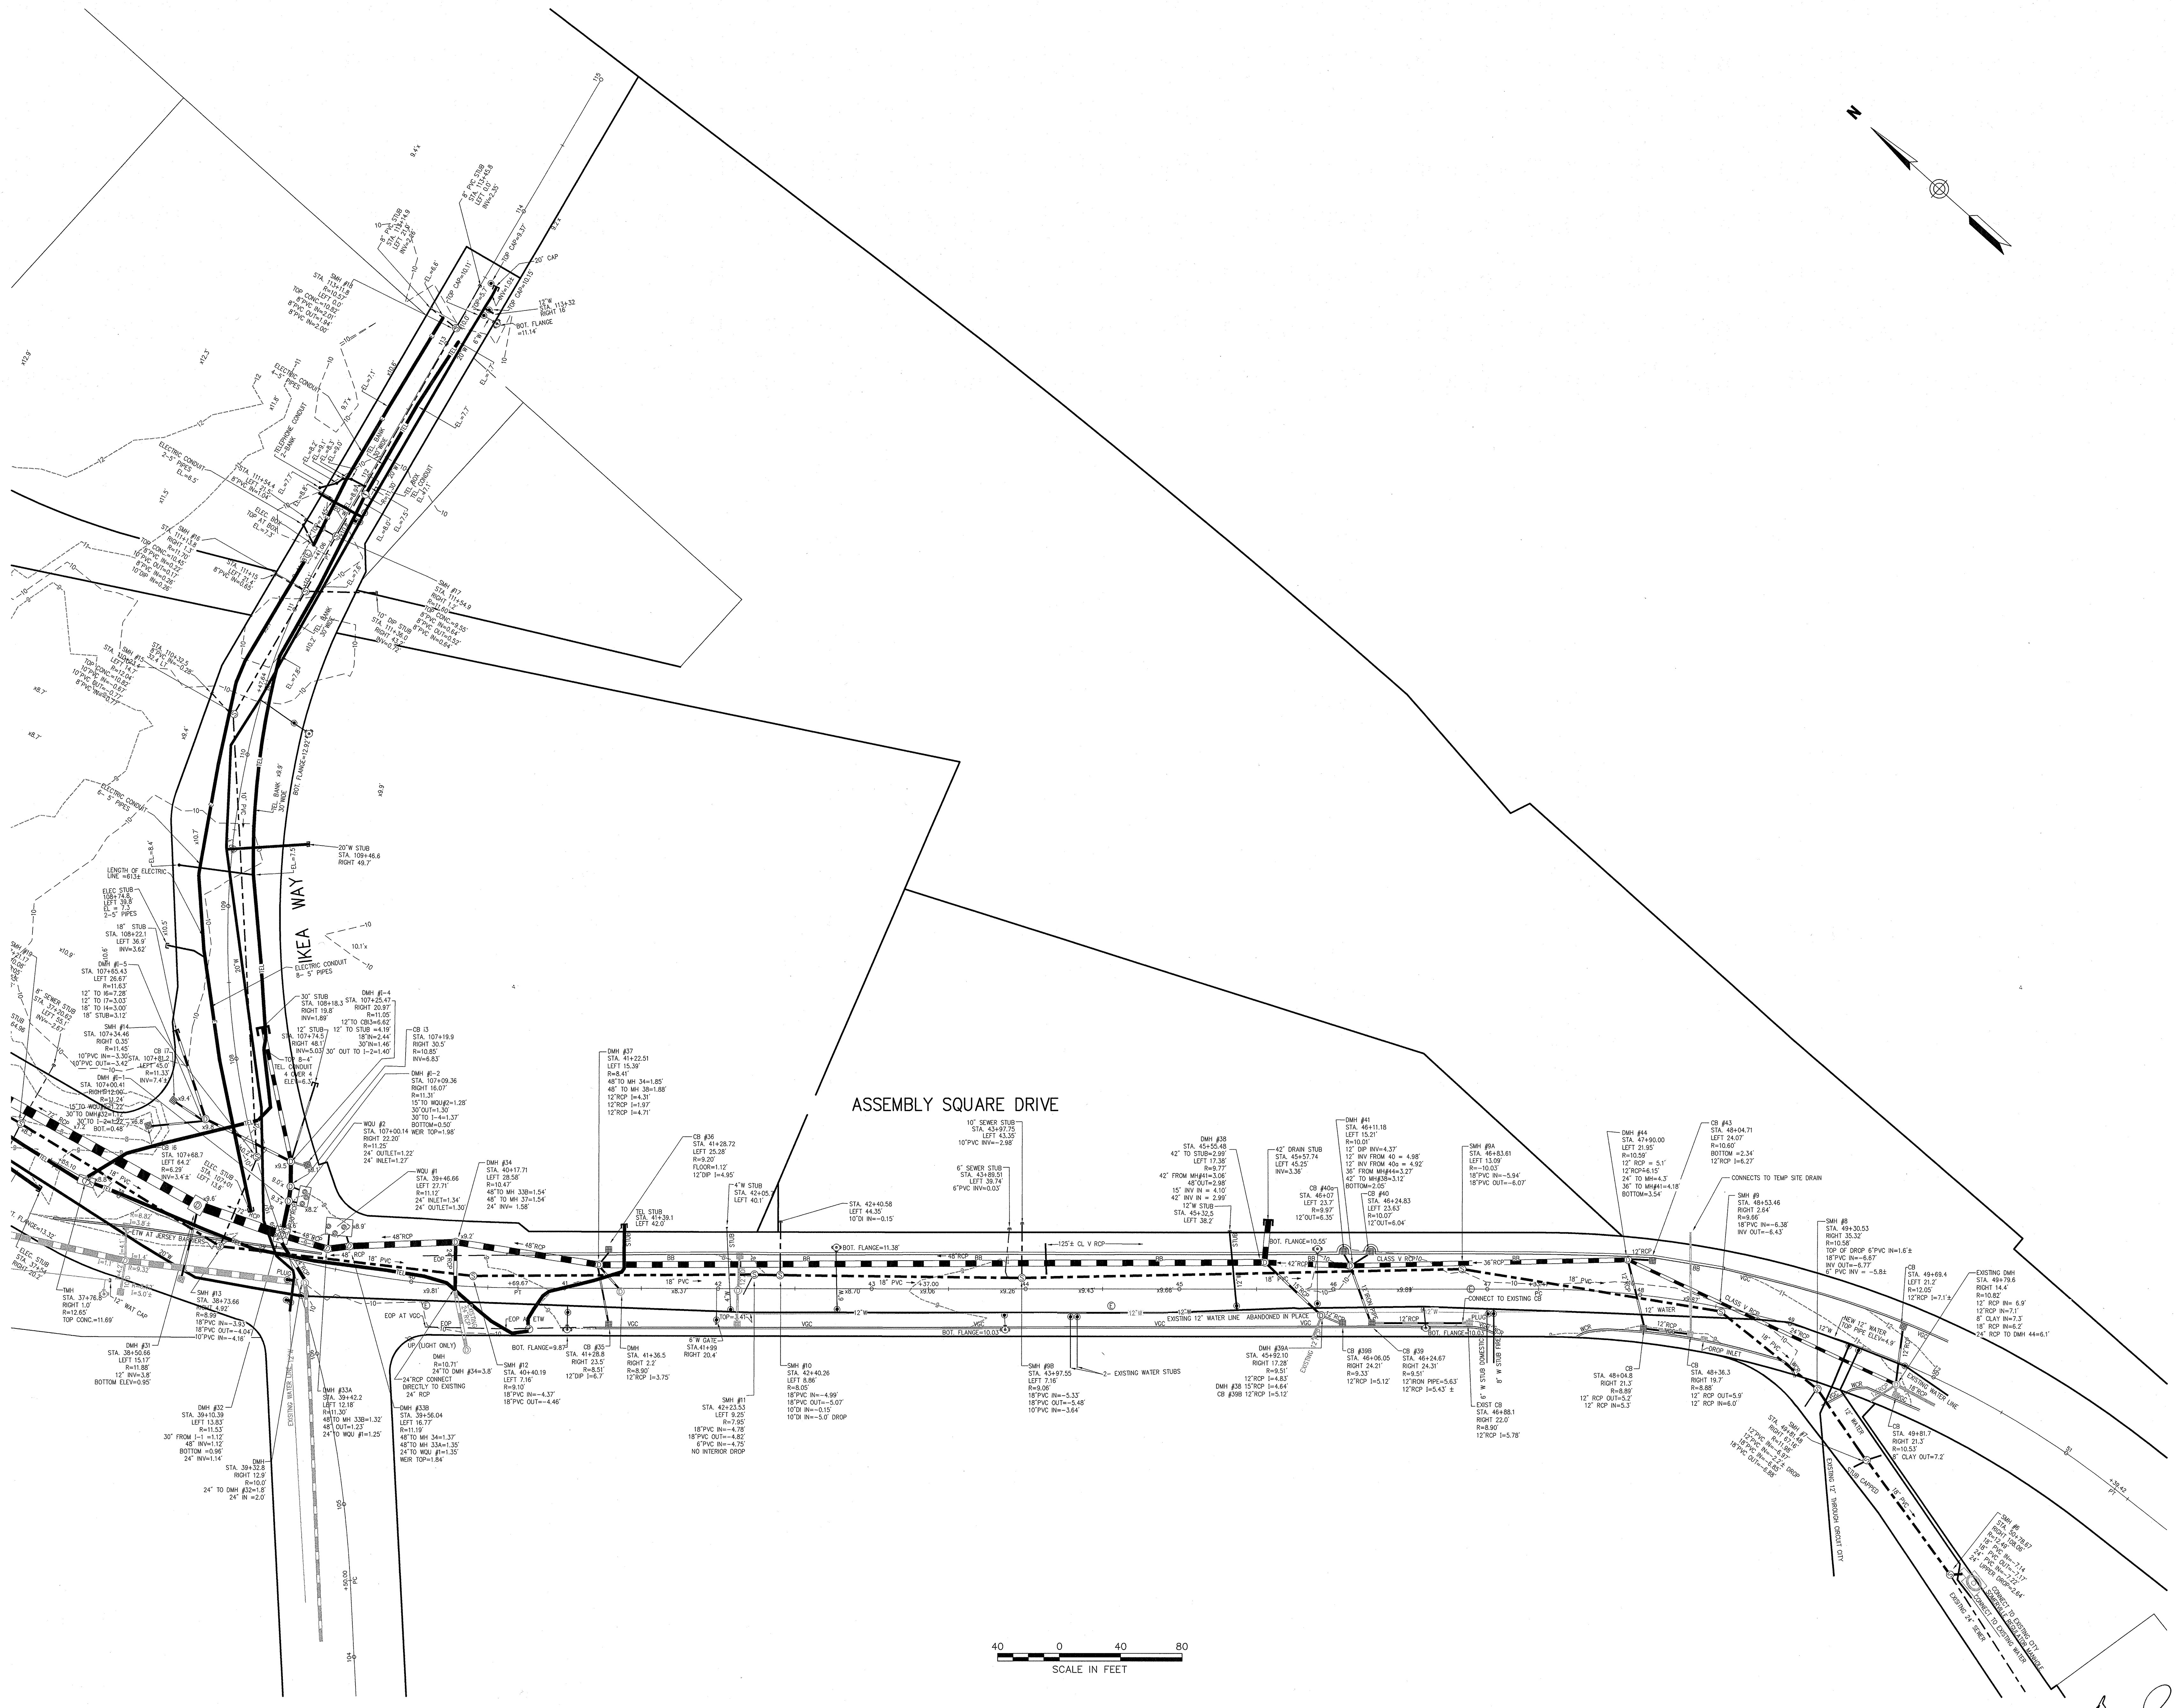

Vanasse Hangen Brustlin, Inc.

Transportation  
Land Development  
Environmental Services

101 Walnut Street, P.O. Box 9151  
Watertown, Massachusetts 02471-9151  
617 924 1770 • FAX 617 924 2286

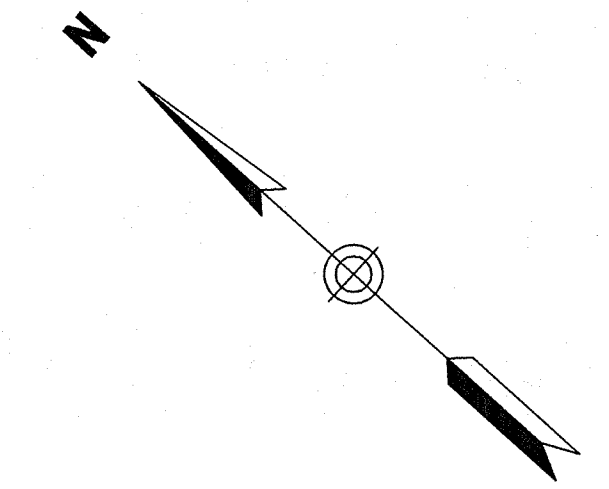


**Legend**

- X,XX ELEVATION NOT OBTAINABLE
- DMH
- CB
- SMH
- EMH
- TMH
- MANHOLE
- HANDHOLE
- WATER GATE
- FIRE HYDRANT
- GAS GATE
- LIGHT POLE
- UTILITY POLE
- GUY WIRE
- GUY POLE
- MONITORING WELL
- EDGE OF PAVEMENT
- CONCRETE CURB
- VERTICAL GRANITE CURB
- SLOPED GRANITE EDGE
- BITUMINOUS BERM
- GUARD RAIL
- CHAIN LINK FENCE
- DRAINAGE LINE
- SEWER LINE
- OVERHEAD WIRE
- UNDERGROUND ELECTRIC
- TELEPHONE LINE
- GAS LINE
- WATER LINE
- R.O.W. LINES

ASSEMBLY SQUARE DRIVE

IKEA WAY

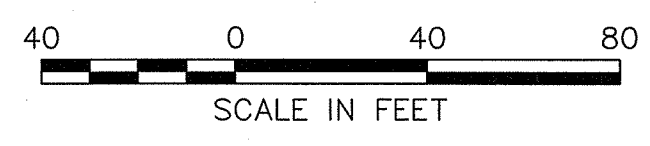

1	edited plan based on peer review comments	3/4/10	bjp
No.	Revision	Date	Apprv.
Designed by	Drawn by	Checked by	Approved by
CAD checked by		Date	January 25, 2010
Scale	1"=40'		

**Assembly Square Drive**

Somerville, Massachusetts

**Utility As-Built  
Plan of Land**

Drawing Title


Utility As-Built  
Plan of Land

Drawing Number  
**Sv-3**

Sheet of  
3 3

Project Number  
10923.00

Project Name  
10923.00 Sewer AB.Dwg

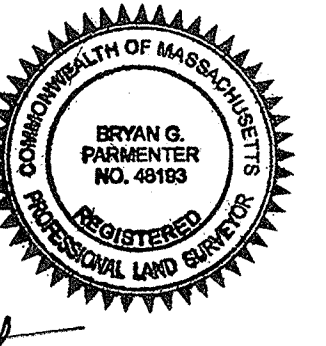

*Bryan G. Brummett* 3/5/2010