



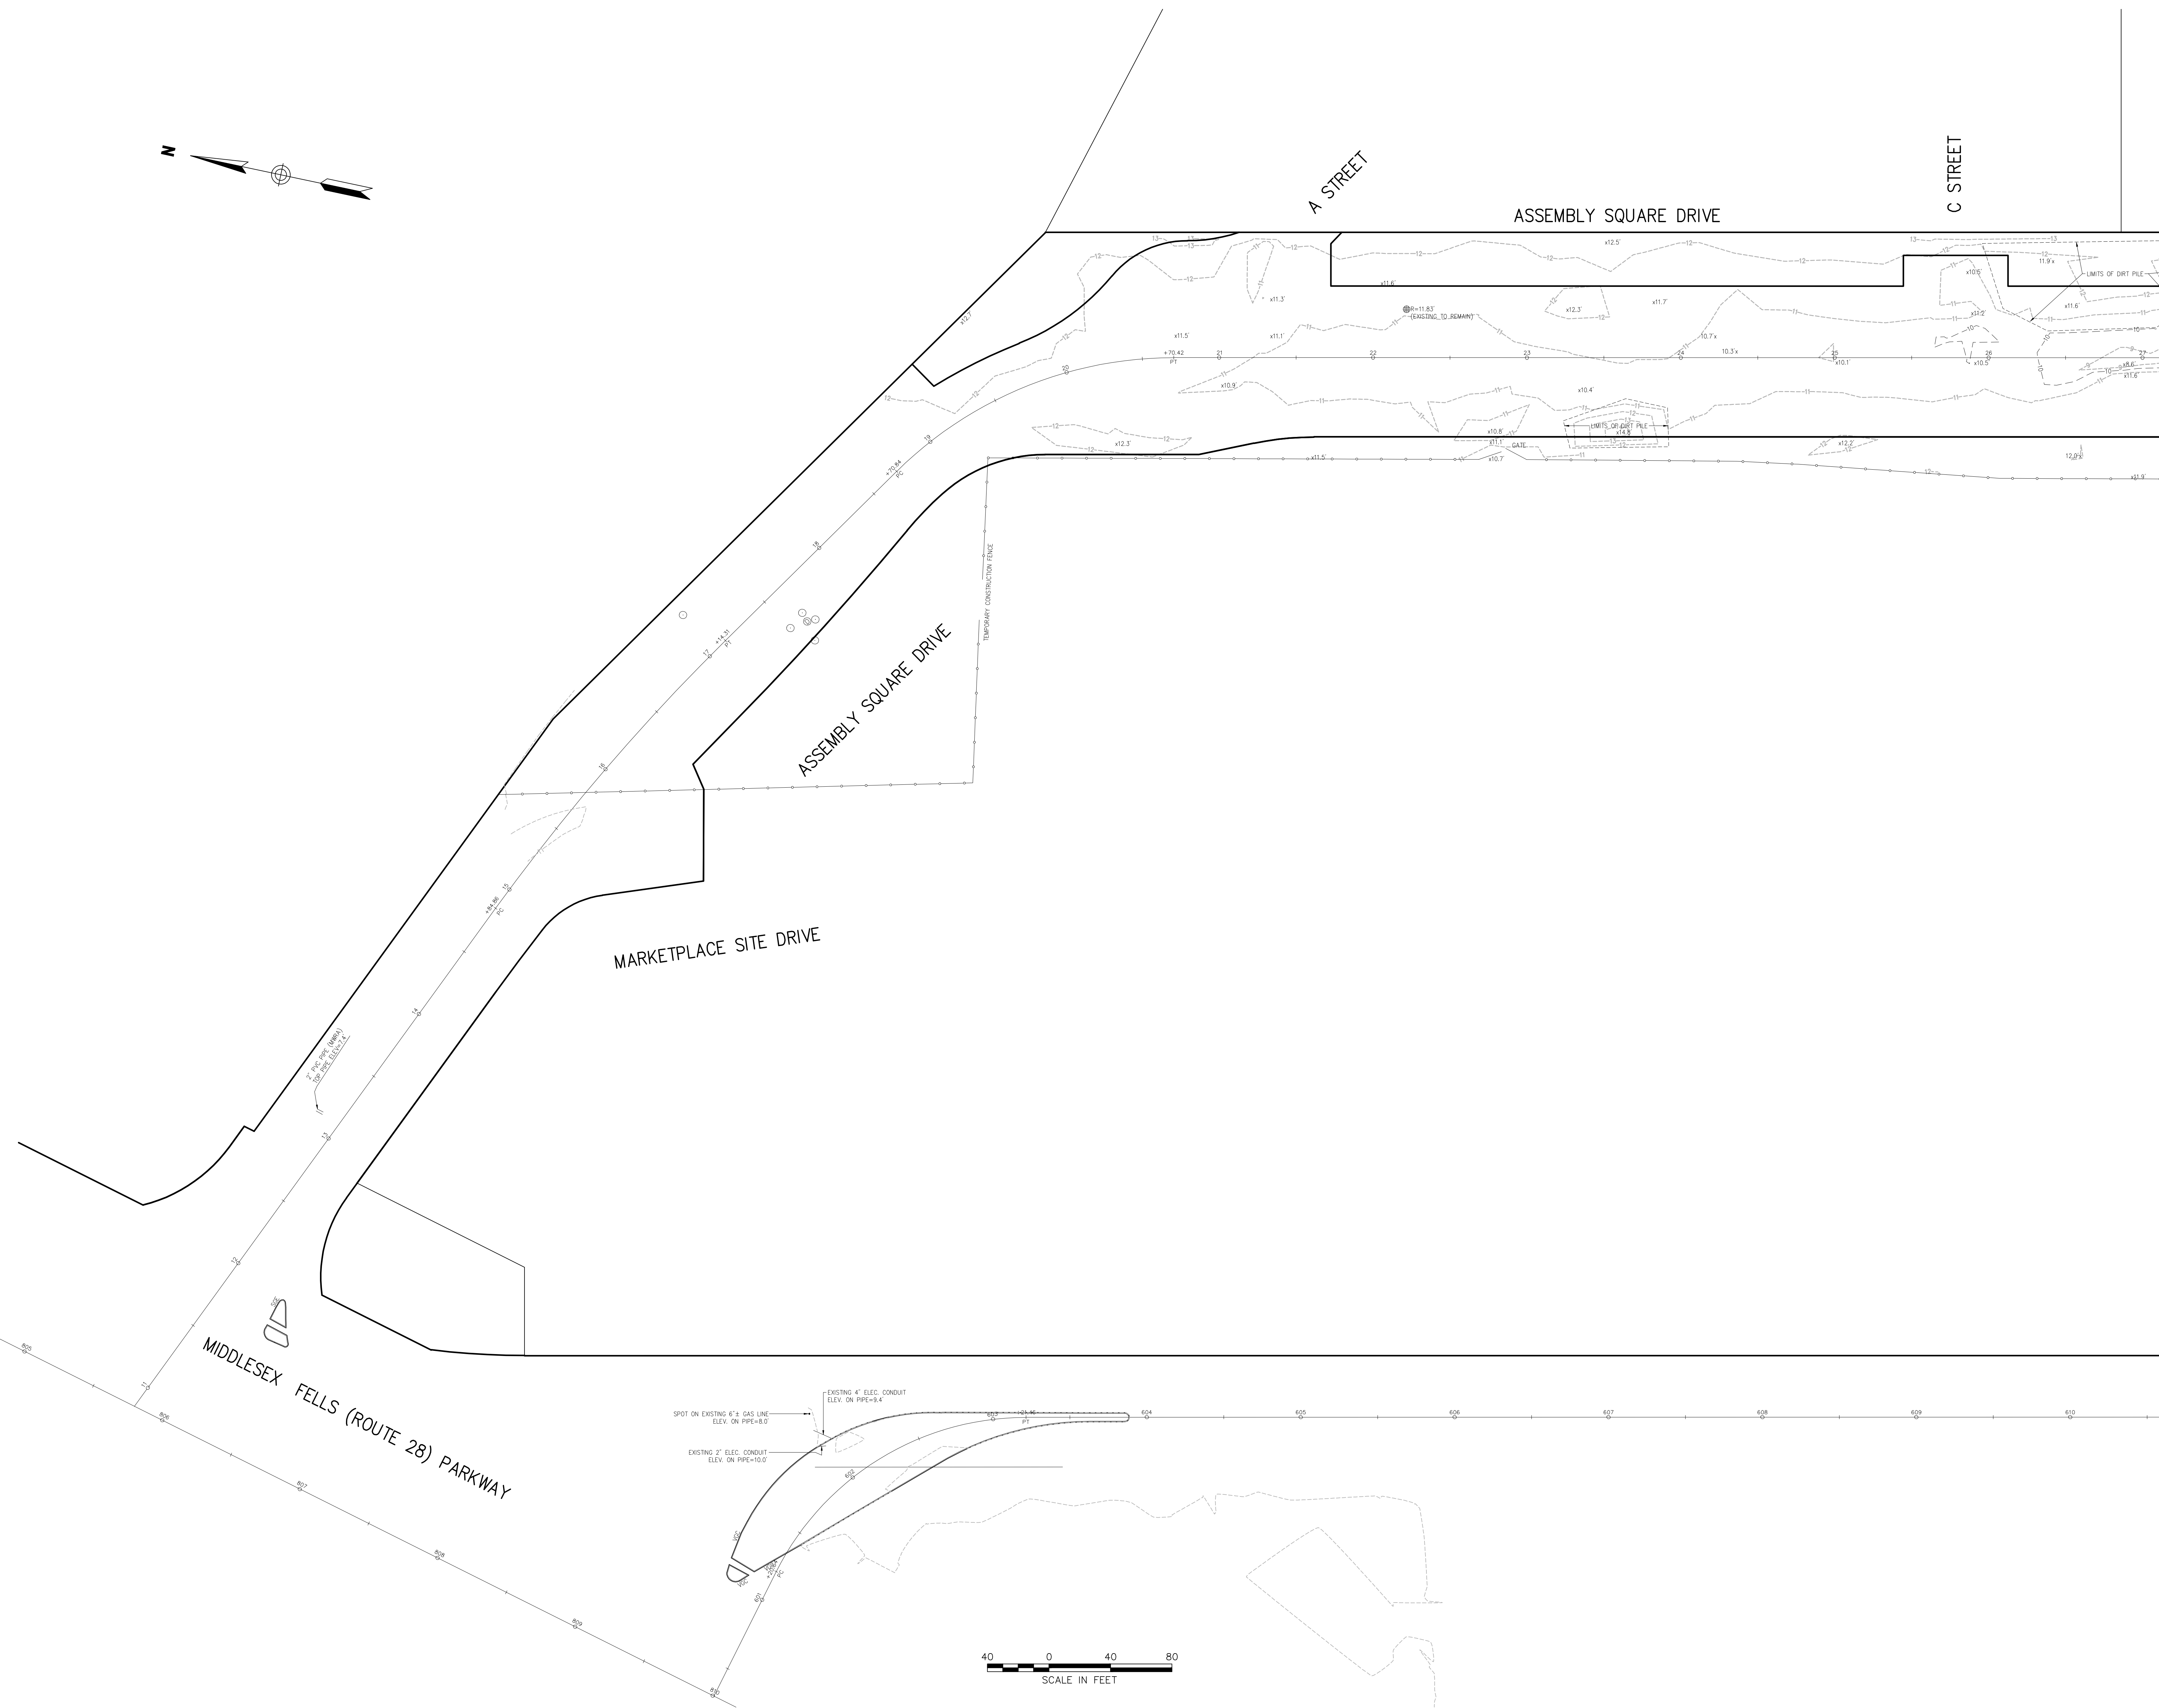

Vanasse Hangen Brustlin, Inc.

Transportation  
Land Development  
Environmental Services

101 Walnut Street, P.O. Box 9151  
Watertown, Massachusetts 02471-9151  
617 924 1770 • FAX 617 924 2286

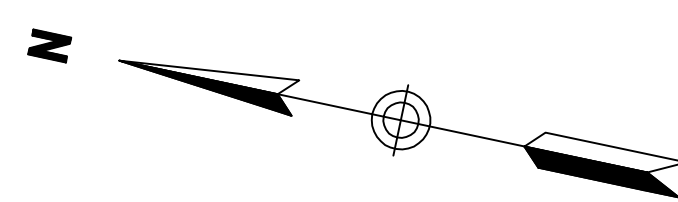

**Legend**

- X, XX' ELEVATION NOT OBTAINABLE
- ⊙ DMI
- ▢ CB
- ⊙ SMH
- ⊙ EMH
- ⊙ TMH
- MANHOLE
- HH ⊙ HANDHOLE
- ★ WATER GATE
- ⊕ FIRE HYDRANT
- GAS GATE
- ☆ LIGHT POLE
- ⊙ UTILITY POLE
- GUY WIRE
- ⊙ GUY POLE
- ⊙ MONITORING WELL
- EOP
- CC
- VCC
- VCG
- SGE
- BTM
- GAF
- CLF
- DL
- SL
- OWL
- UWL
- TEL
- GAS
- W
- R.O.W. LINES


1		edited plan based on peer	3/4/10	hjs
No.		review comments	Date	Revised

Designed by      Drawn by      Checked by  
CAD checked by      Approved by  
Scale: **1"=40'**      Date: **January 25, 2010**  
Project Title

**Assembly Square Drive**  
Somerville, Massachusetts

Drawing Title  
**Drain As-Built  
Plan of Land**

Drawing Number  
**Sv-1**

Sheet of  
**1 3**

Project Number  
**10923.00**