

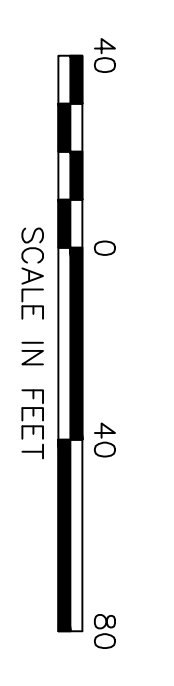


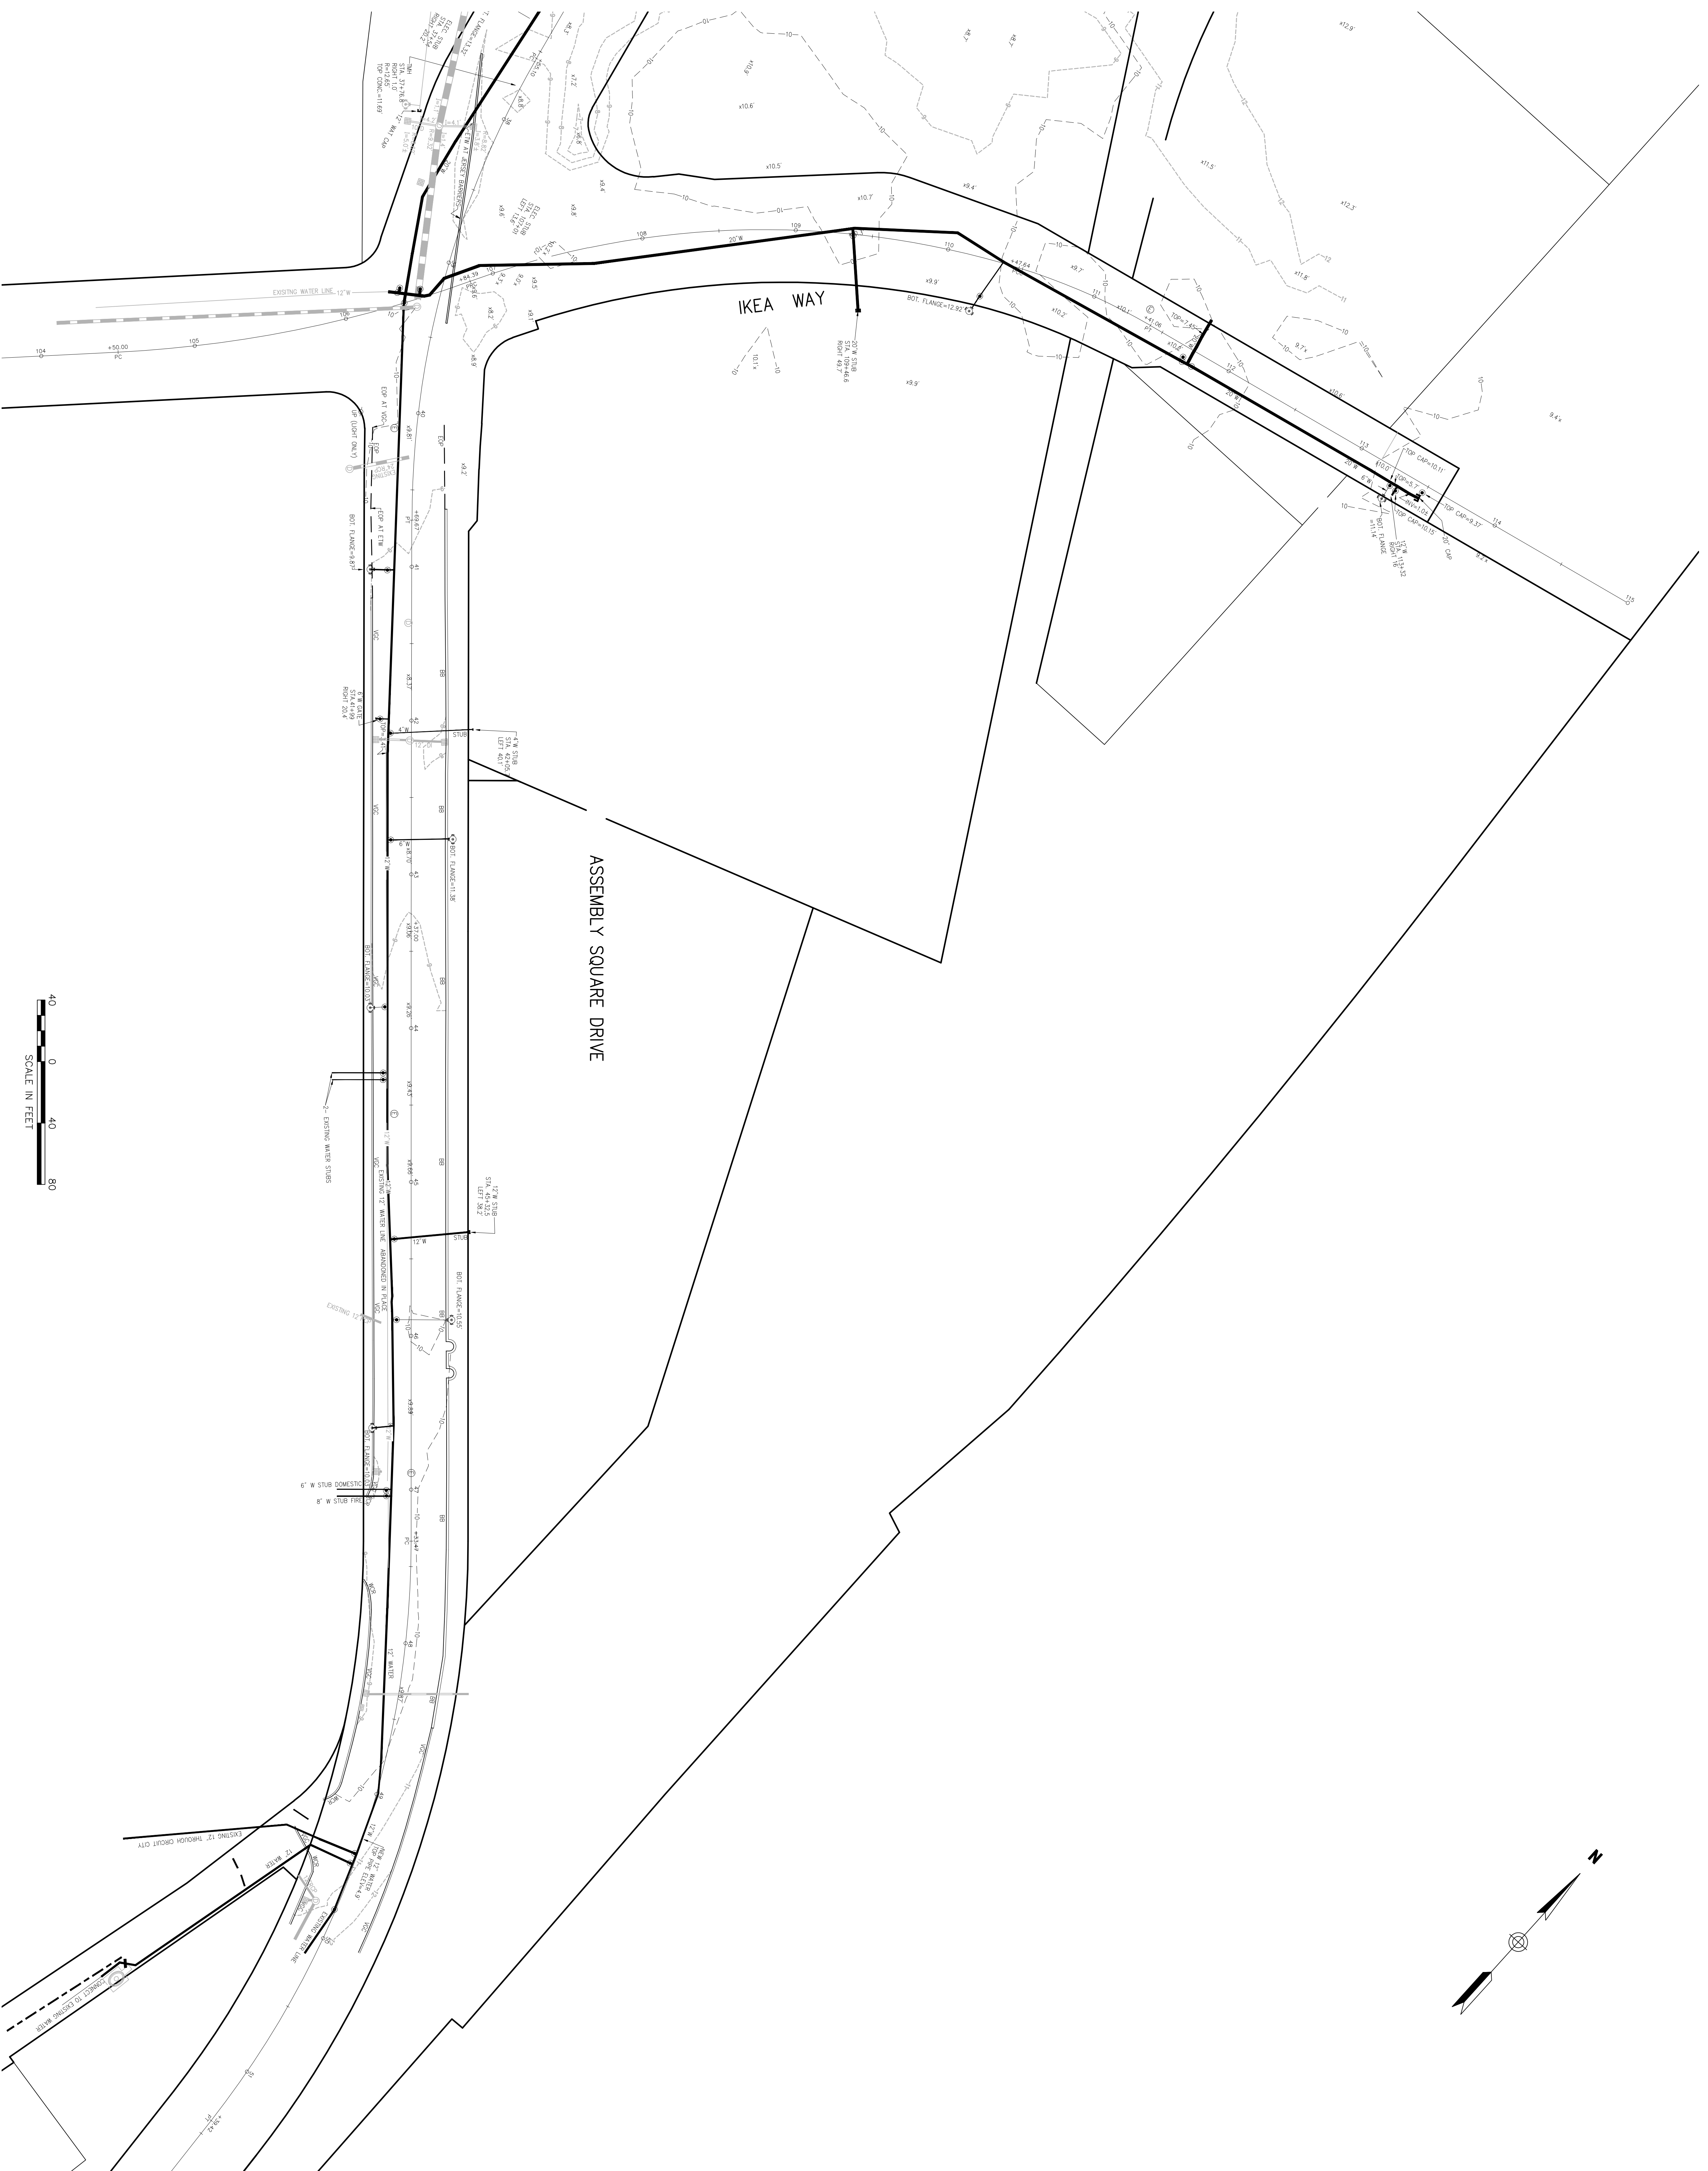

Yanase Hangen Brushin, Inc.
 Transportation
 Land Development
 Environmental Services
 101 Walnut Street, P.O. Box 9151
 Watertown, Massachusetts 02471-9151
 617.924.1770 • FAX 617.924.2286

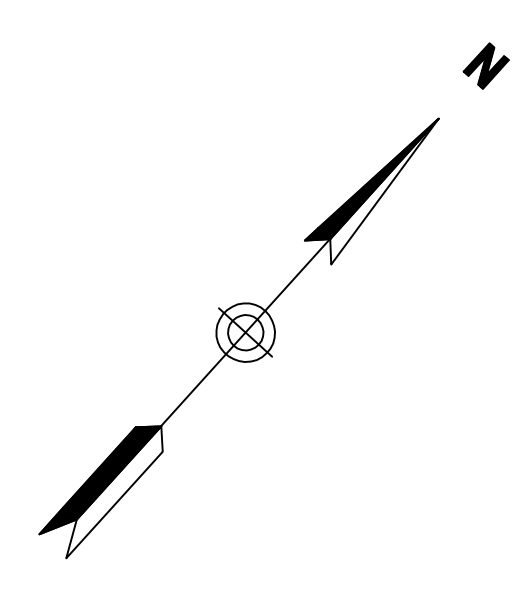

- Legend**
- X, X' ELEVATION NOT OBTAINABLE
 - CB
 - SMH
 - SMH
 - SMH
 - MANHOLE
 - WATER GATE
 - WATER GATE
 - GAS GATE
 - LIGHT POLE
 - UTILITY POLE
 - GUY POLE
 - MONITORING WELL
 - EDGE OF PAVEMENT
 - VERTICAL GRANITE CURB
 - SLOPED GRANITE EDGE
 - BITUMINOUS BEAM
 - CHANGING LINK FENCE
 - SEWER LINE
 - OVERHEAD AND ELECTRIC
 - TELEPHONE LINE
 - GAS LINE
 - WATER LINE
 - POW. LINES

NO.	DESCRIPTION	DATE	BY
1	initial plan based on survey	5/7/10	SP
2	revisions		
3	revisions		

2-D0 created by: [blank] checked by: [blank]
 2-D0 checked by: [blank] checked by: [blank]

Project Title: **Assembly Square Drive**
 Scale: **1"=40'** Date: **January 25, 2010**

Somerville, Massachusetts

Project Name:
Water As-Built
Plan of Land

SV-3

Sheet 3 of 3
 Project Number: 10923.00

\\Masdevil\1\10923.00\work\plan\assembly\10923.00_Survey_Alt.dwg