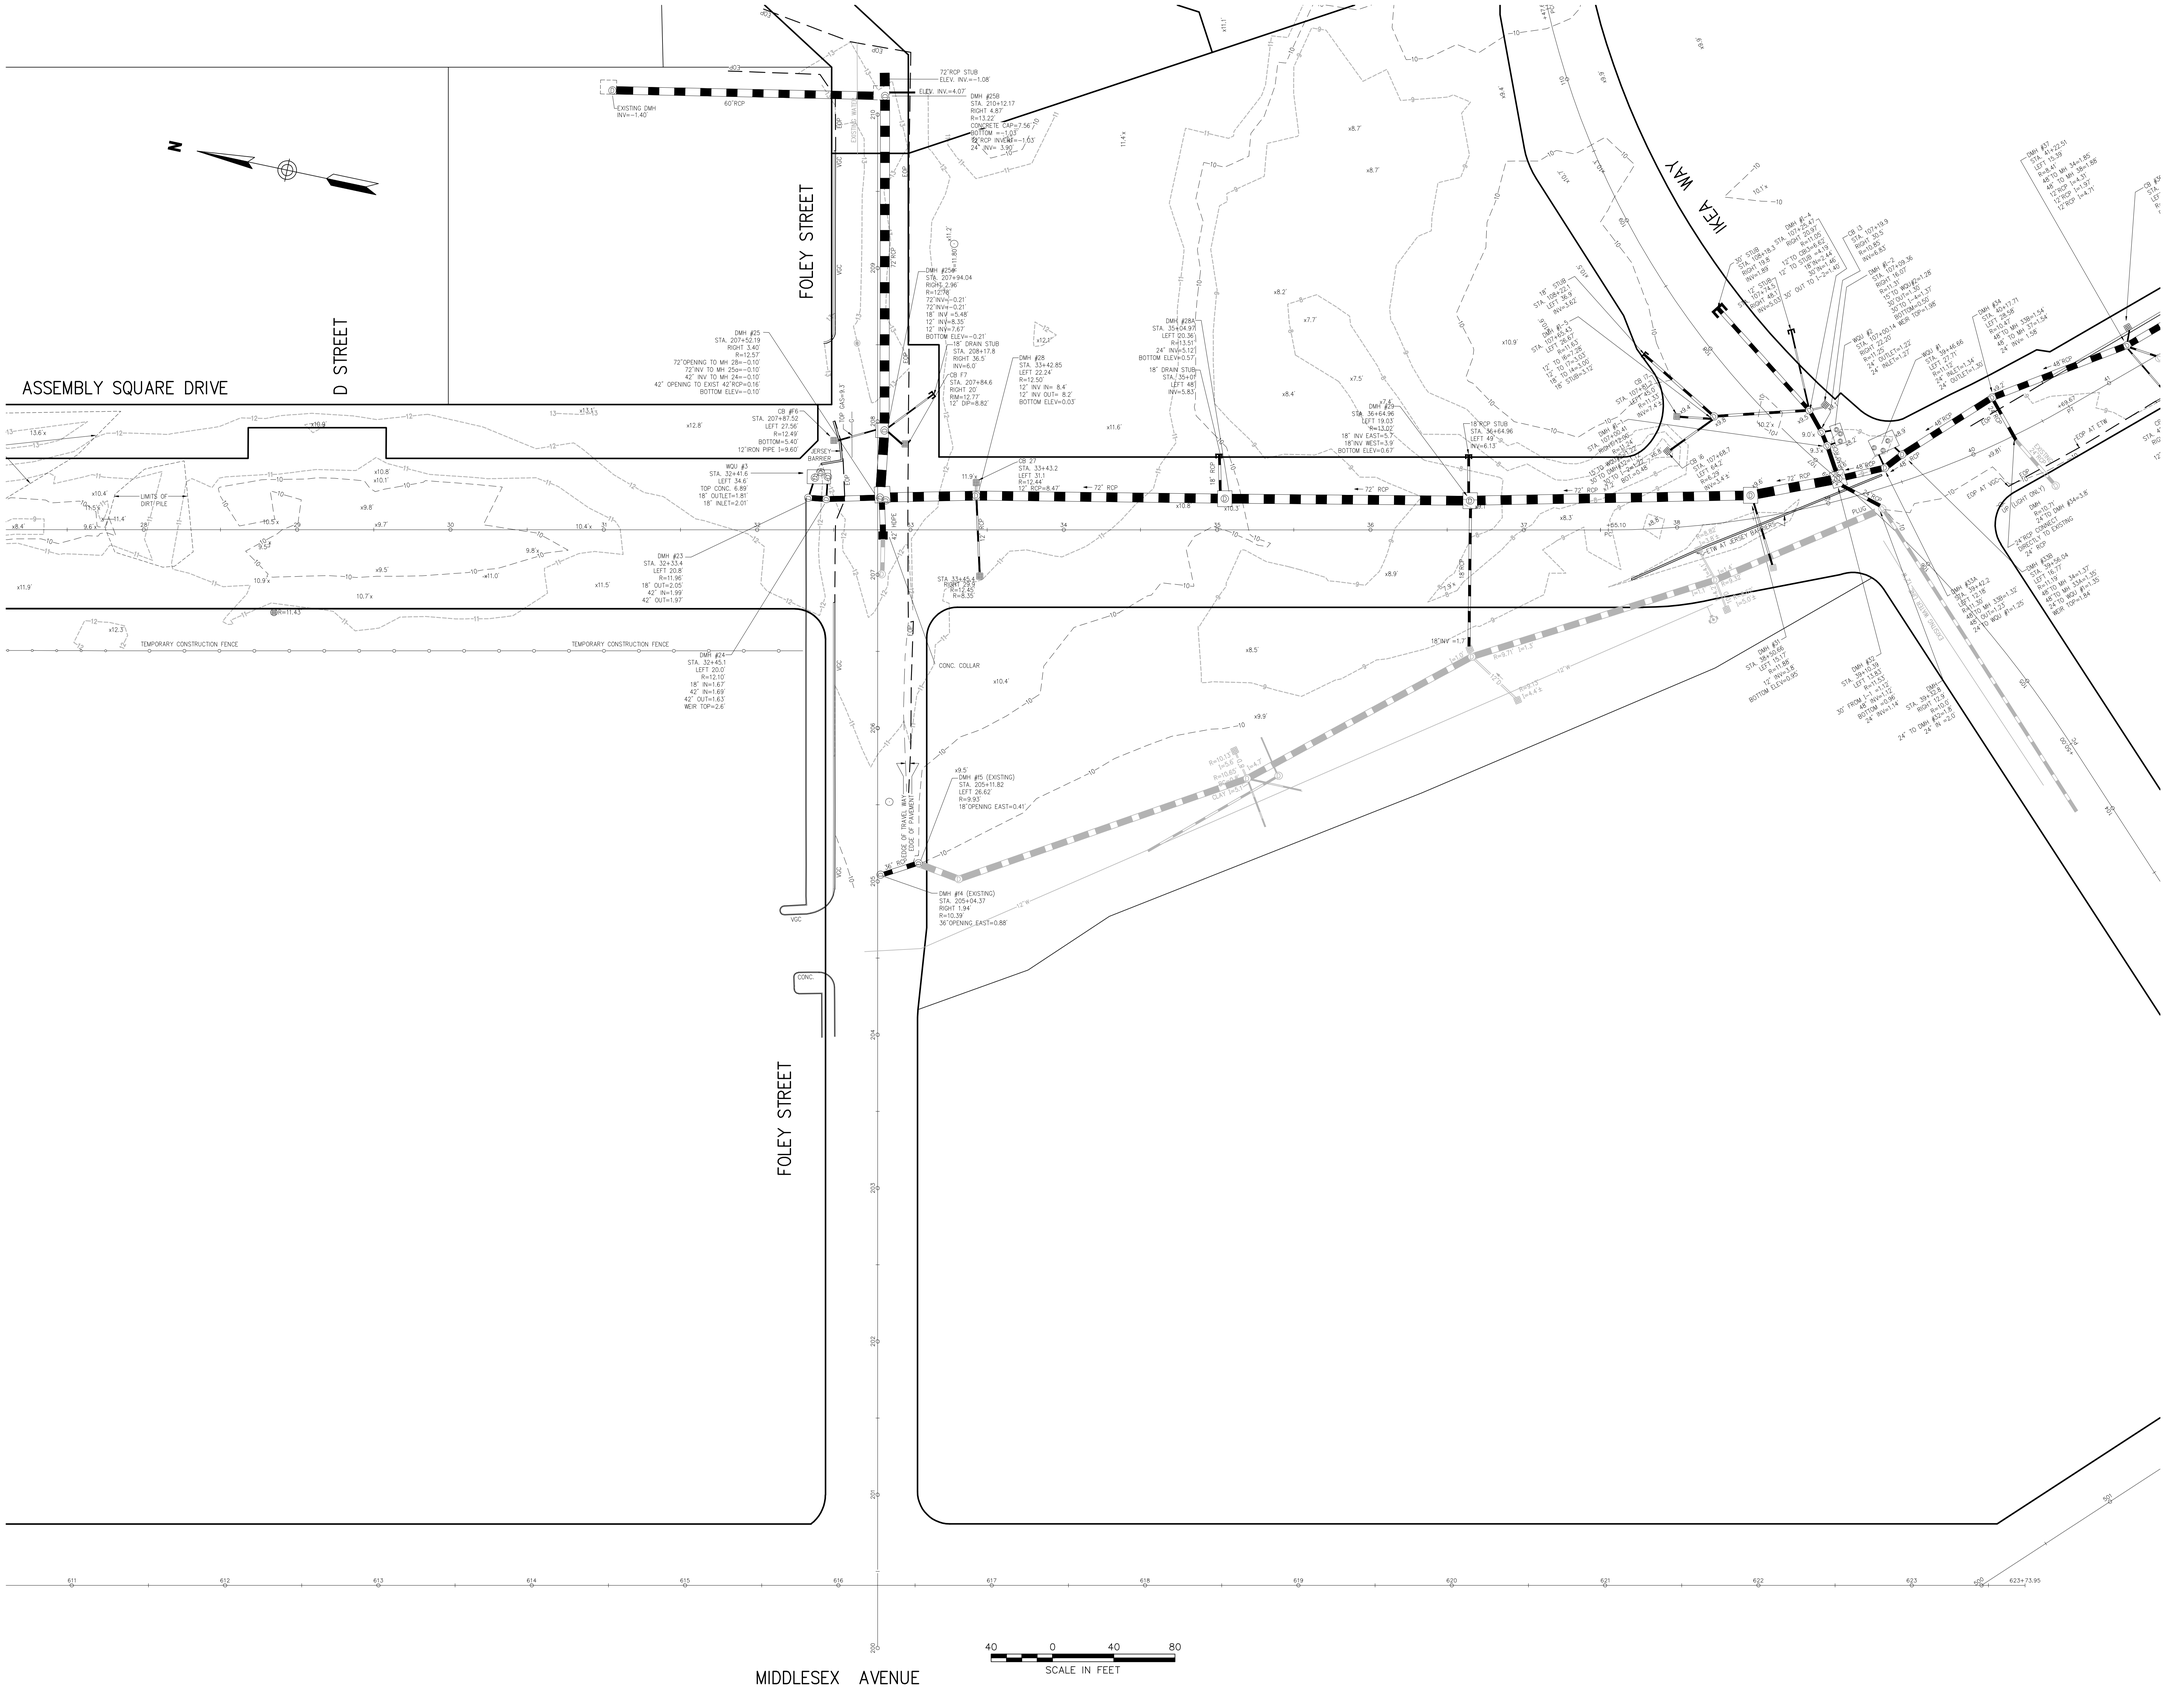

VHB

Vanasse Hangen Brustlin, Inc.

Transportation
Land Development
Environmental Services

101 Walnut Street, P.O. Box 9151
Watertown, Massachusetts 02471-9151
617 924 1770 • FAX 617 924 2286

Legend

- X.XX ELEVATION NOT OBTAINABLE
- DMH
- CB
- SMH
- EMH
- TMH
- MANHOLE
- HANDHOLE
- WATER GATE
- FIRE HYDRANT
- GAS GATE
- LIGHT POLE
- UTILITY POLE
- GUY WIRE
- GUY POLE
- MONITORING WELL
- EOP — EDGE OF PAVEMENT
- CC — CONCRETE CURB
- VGC — VERTICAL GRANITE CURB
- SGE — SLOPED GRANITE EDGE
- BB — BITUMINOUS BERM
- GUARD RAIL
- CHAIN LINK FENCE
- DRAINAGE LINE
- SEWER LINE
- OHW — OVERHEAD WIRE
- E — UNDERGROUND ELECTRIC
- T — TELEPHONE LINE
- G — GAS LINE
- W — WATER LINE
- R.O.W. LINES

No.	Revision	Date	Appvd.
1	edited plan based on peer review comments	3/4/10	bgp

Designed by | Drawn by | Checked by
CAD checked by | Approved by
Scale 1"=40' | Date January 25, 2010

Project Title
Assembly Square Drive

Somerville, Massachusetts
Issued for

Drawing Title
Drain As-Built Plan of Land

Drawing Number
Sv-2

Sheet 2 of 3

Project Number
10923.00

\\Mawald\d\10923.00\cad\sr\planset\10923.00_Sewer_AB.dwg