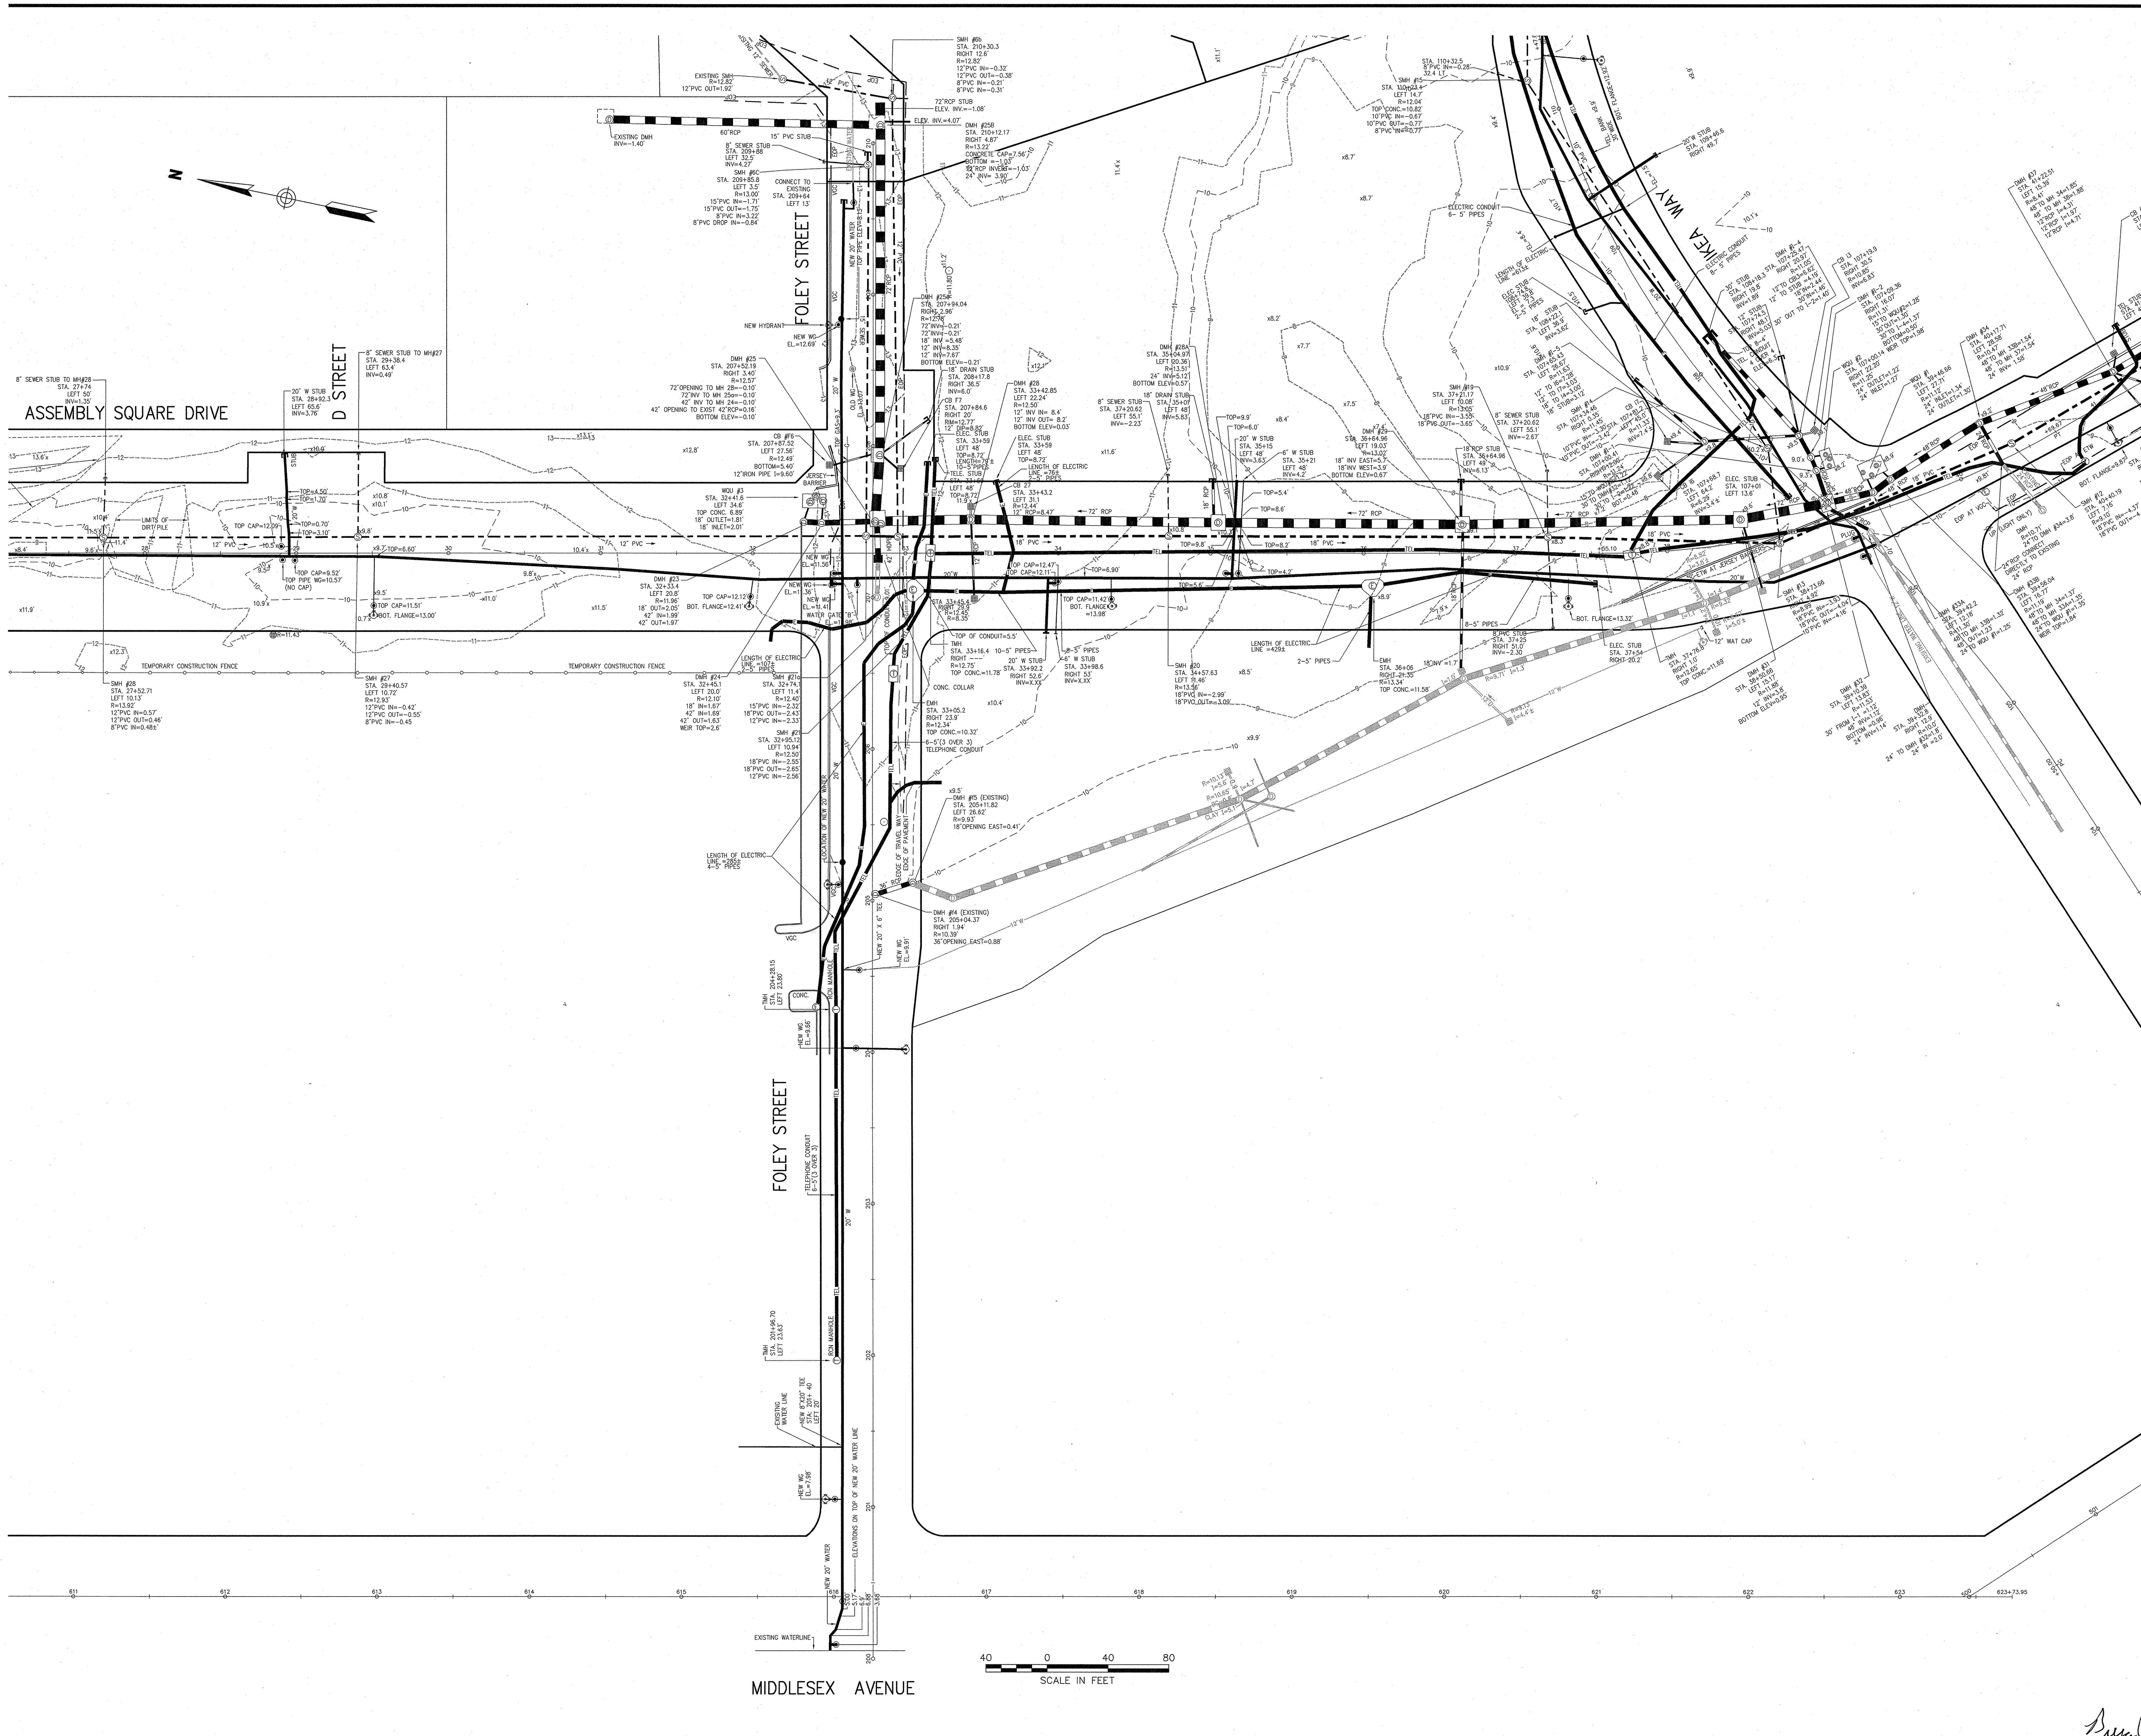

Vanasse Hangen Brustlin, Inc.

Transportation
Land Development
Environmental Services

101 Walnut Street, P.O. Box 9151
Watertown, Massachusetts 02471-9151
617 924 1770 • FAX 617 924 2286

Legend

X.XX' ELEVATION NOT OBTAINABLE
DMH
CB
SMH
EMH
TMH
MANHOLE
HH HANDHOLE
WATER GATE
FIRE HYDRANT
GAS GATE
LIGHT POLE
UTILITY POLE
GUY WIRE
GUY POLE
MW MONITORING WELL
EOP EDGE OF PAVEMENT
CC CONCRETE CURB
VGC VERTICAL GRANITE CURB
SGE SLOPED GRANITE EDGE
BB BITUMINOUS BERM
GUARD RAIL
CHAIN LINK FENCE
DRAINAGE LINE
SEWER LINE
OHW OVERHEAD WIRE
E UNDERGROUND ELECTRIC
T TELEPHONE LINE
G GAS LINE
W WATER LINE
R.O.W. LINES

No.	Revision	Date	Appvd.
1	edited plan based on peer review comments	3/4/10	bgp

Designed by | Drawn by | Checked by
CAD checked by | Approved by
Scale 1"=40' | Date January 25, 2010

Project Title
Assembly Square Drive

Somerville, Massachusetts

Issued for

Drawing Title
Utility As-Built Plan of Land

Drawing Number **Sv-2**

Sheet 2 of 3

Project Number 10923.00

COMMONWEALTH OF MASSACHUSETTS — BRYAN G. PARMENTER NO. 48193 — REGISTERED PROFESSIONAL LAND SURVEYOR

3/5/2010

\\Mawald\ld\10923.00\cad\sr\planset\10923.00_Sewer_AB.dwg